


Give All Information Completely  
Make Required Affidavit  
Mail or Deliver Report to:  
Conservation Division  
State Corporation Commission  
212 North Market, Insurance Bldg.  
Wichita, Kansas

Barton County. Sec. 13 Twp. 16 Rge. 12 (~~E~~) (W)  
Location as "NE/CNW/SE" or footage from lines. SE NW NE  
Lease Owner Icer Addis  
Lease Name Holder Well No. 1  
Office Address Great Bend, Kansas  
Character of Well (completed as Oil, Gas or Dry Hole) Dry Hole  
Date well completed September 1 19 64  
Application for plugging filed September 1 19 64  
Application for plugging approved September 1 19 64  
Plugging commenced September 1 19 64  
Plugging completed September 1 19 64  
Reason for abandonment of well or producing formation Dry Hole

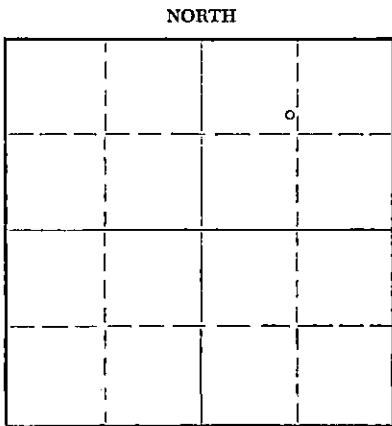

Locate well correctly on above Section Plat

If a producing well is abandoned, date of last production 19  
Was permission obtained from the Conservation Division or its agents before plugging was commenced? Yes

Name of Conservation Agent who supervised plugging of this well Gilbert Toman  
Producing formation \_\_\_\_\_ Depth to top \_\_\_\_\_ Bottom \_\_\_\_\_ Total Depth of Well \_\_\_\_\_ Feet  
Show depth and thickness of all water, oil and gas formations.

OIL, GAS OR WATER RECORDS

CASING RECORD

FORMATION	CONTENT	FROM	TO	SIZE	PUT IN	PULLED OUT

Describe in detail the manner in which the well was plugged, indicating where the mud fluid was placed and the method or methods used in introducing it into the hole. If cement or other plugs were used, state the character of same and depth placed, from \_\_\_\_\_ feet to \_\_\_\_\_ feet for each plug set.

Filled hole with heavy mud to 225' and set plug and hulls and 25 sacks cement through drill pipe.

Filled hole with heavy mud to 40' and set plug and hulls and 10 sacks cement.

Put 2 sacks of cement in rat hole.

RECEIVED  
STATE CORPORATION COMMISSION

OCT 30 1964 10-30-64

CONSERVATION DIVISION  
Wichita, Kansas

(If additional description is necessary, use BACK of this sheet)  
Name of Plugging Contractor Burt Drilling Co.  
Address Great Bend, Kansas

STATE OF XXXXXX Kansas, COUNTY OF Barton, ss.  
Duke C. Burt (employee of owner) or (owner or operator) of the above-described well, being first duly sworn on oath, says: That I have knowledge of the facts, statements, and matters herein contained and the log of the above-described well as filed and that the same are true and correct. So help me God.

(Signature) Duke C. Burt  
1823 Washington, Great Bend, Kansas  
(Address)

SUBSCRIBED AND SWORN TO before me this 28 day of October, 1964

My commission expires April 2, 1968

Francis A. Bell  
Notary Public.



ICER ADDIS  
 XXXXXXXXXXXXXXXXXXXX  
 Great Bend, Kansas

Well: Holder No. 1  
 Commenced R.D.: 8/24/64  
 Completed R.D.: 9/1/64  
 Total Depth: 3,322' D.F.  
 Casing: 230' of 8 5/8 8 rd. thd.

Sec. 13-16-12W  
 Barton County, Kansas  
 Elevation:  
 Initial Prod.: D & A  
 Contractor: BURT DRILLING  
 COMPANY

Strata	Depth
Post Rock	0- 60'
Shale & Gyp	60- 150
Shale & redbed	150- 300
Shale & shells	300- 330
Sand	330- 390
Shale & shells	390-1390
Shale & lime streaks	1390-1965
Shale & lime	1965-2055
Shale & lime streaks	2055-2640
Lime & shale streaks	2640-2700
Lime	2700-2920
Shale (Heebner)	2920-2924
Lime & shale	2924-2946
Lime (Toronto)	2946-2950
Lime	2950-2953
Shale	2953-3012
Lime (Brown)	3012-3032
Lime (Lansing)	3032-3065
Lime	3065-3310
Conglomerate	3310-3322

I hereby certify that the above is a true and correct log of said well as reflected by daily reports.

BURT DRILLING CO.

*[Signature]*

Signed and sworn to in my presence this 10th day of September, 1964.

*Francis A. Bell*  
 Notary Public

My Commission Expires: April 2, 1968

