


Give All Information Completely
Make Required Affidavit
Mail or Deliver Report to:
Conservation Division
State Corporation Commission
800 Biting Building
Wichita, Kansas

WELL PLUGGING RECORD

NORTH

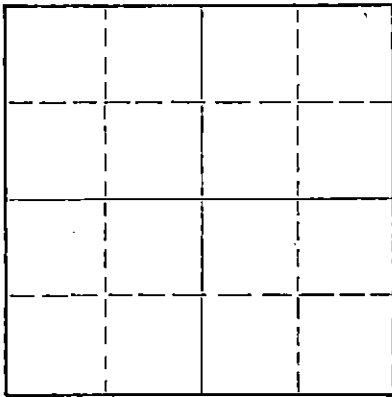

Locate well correctly on above
Section Plat

Hodgeman County, Sec. 29 Twp. 21 Rge. 21 (E) (W)
Location as "NE/CNW%SW%" or footage from lines NW NW SW
Lease Owner Trans Era Petroleum, Inc.
Lease Name Regnier Well No. 1
Office Address Russell, Kansas
Character of Well (completed as Oil, Gas or Dry Hole) Dry Hole
Date well completed 9/2/55 19
Application for plugging filed 9/1/55 19
Application for plugging approved 9/1/55 19
Plugging commenced 9/2/55 19
Plugging completed 9/2/55 19
Reason for abandonment of well or producing formation Dry Hole

If a producing well is abandoned, date of last production _____ 19____
Was permission obtained from the Conservation Division or its agents before plugging was commenced? yes

Name of Conservation Agent who supervised plugging of this well M. A. Rives
Producing formation _____ Depth to top _____ Bottom _____ Total Depth of Well 4865 Feet
Show depth and thickness of all water, oil and gas formations.

OIL, GAS OR WATER RECORDS

CASING RECORD

FORMATION	CONTENT	FROM	TO	SIZE	PUT IN	PULLED OUT
				8 5/8	410	none

Describe in detail the manner in which the well was plugged, indicating where the mud fluid was placed and the method or methods used in introducing it into the hole. If cement or other plugs were used, state the character of same and depth placed, from _____ feet to _____ feet for each plug set.

PLUGGING RECORD

Filled hole with heavy mud to 400'. Layed 1st plug, using 1/2 hulls and 20 sacks cement. Filled hole with heavy mud to 35', using 1/2 sack hulls and 10 sacks cement.

(If additional description is necessary, use BACK of this sheet)

Name of Plugging Contractor _____
Address _____

STATE OF KANSAS, COUNTY OF RUSSELL, ss.
Robert B. Snyder (employee of owner) or (owner or operator) of the above-described well, being first duly sworn on oath, says: That I have knowledge of the facts, statements, and matters herein contained and the log of the above-described well as filed and that the same are true and correct. So help me God.

(Signature) Robert B. Snyder

(Address) _____

SUBSCRIBED AND SWORN TO before me this 12th day of September, 1955

Marge Cooper

My commission expires 1-30-57

Notary Public.
M. H. D.
Notary Public

PLUGGING
FILE SEC 29 T 21 R 21 W
BOOK PAGE 142 LINE 31

9-14-55

Trans Era Petroleum, Inc.
Regnier #1

NW NW SW Section 29-21-21
Hodgeman County, Kansas

Total Depth: 4865'

Comm: 8/11/55
Comp: 9/2/55

Casing:
8 5/8" @ 410'

Cement
225 sacks of Bulk

FORMATION	DEPTH
Clay & sand	30
Post rock	35
Clay & shale	150
Sand & shale	405
Shale	712
Anhydrite	745
Shale & sand	1075
Redbed, shale & shells	1450
Shale & shells	1675
Shale	2080
Shale & Lime	3594
Lime	3686
Lime & shale	3755
Lime	4167
Lime & shale	4411
Mississippi	4440
Lime & chert	4527
Lime	4568
Lime & shale	4591
Lime & chert	4715
Lime	4865

STATE OF KANSAS)
) ss:
COUNTY OF RUSSELL)

I hereby certify that the above information is true and correct
to the best of my knowledge.

Robert B. Snyder

Subscribed and sworn to before me this 12th day of September, 1955.

Margie Cooper

Notary Public

My commission expires: 1-30-57

NOTARY PUBLIC
DIVISION
Kansas

PLUGGING
FILE SEC. 29 T. 21 R. 21W
BLOCK PAGE 47 LINE 21