


STATE OF KANSAS  
STATE CORPORATION COMMISSION

WELL PLUGGING RECORD

Give All Information Completely  
Make Required Affidavit  
Mail or Deliver Report to  
Conservation Division  
State Corporation Comm.  
245 North Water  
Wichita, KS 67202

Hamilton County, Sec. 30 Twp. 21 Rge. 39 E/W  
Location as "NE/CNW $\frac{1}{4}$ SW $\frac{1}{4}$ " or footage from lines  
10' NE of center Section into NE  $\frac{1}{4}$  (20' N+ 20' W of C Sec.)  
Lease Owner Dernick Land Company  
Lease Name Lunt Well No. 1  
Office Address 225 Katy Freeway Suite 112 Houston, Texas 77024  
Character of Well (Completed as Oil, Gas or Dry Hole)

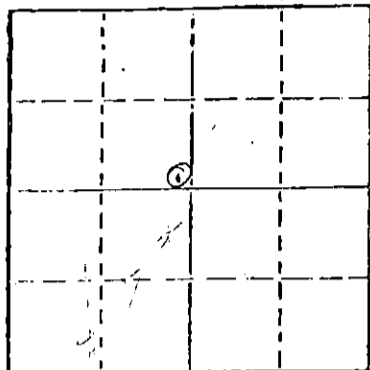

Locate well correctly on above  
Section Plat

Date Well completed 6-8 19 79  
Application for plugging filed 6-8 19 79  
Application for plugging approved 6-8 19 79  
Plugging commenced 6-8 19 79  
Plugging completed 7:00 P.M. 6-8 19 79  
Reason for abandonment of well or producing formation  
Dry Hole

If a producing well is abandoned, date of last production 19

Was permission obtained from the Conservation Division or its agents before plugging was commenced?

Name of Conservation Agent who supervised plugging of this well  
Producing formation Depth to top Bottom Total Depth of Well 2815  
Show depth and thickness of all water, oil and gas formations.

OIL, GAS OR WATER RECORDS

CASING RECORD

FORMATION	CONTENT	FROM	TO	SIZE	PUT IN	PULLED OUT
Blue Shale			334'	8 5/8"	X	Left in

Describe in detail the manner in which the well was plugged, indicating where the mud fluid was placed and the method or methods used in introducing it into the hold. If cement or other plugs were used, state the character of same and depth placed, from feet to feet for each plug set. Plug with 60 Sx 385' to 250'

10 Sx 40' to 0'  
5 Sx Rathole

Total of 75 Sx 50/50 POZ with 6% Gel  
Halliburton Pump Truck

RECEIVED  
STATE CORPORATION COMMISSION

JUL - 9 1979

CONSERVATION DIVISION  
Wichita, Kansas

(If additional description is necessary, use BACK of this sheet)

Name of Plugging Contractor Lakin Drilling Company

STATE OF Kansas COUNTY OF Kearny, ss.  
(employee of owner) or (owner or operator)  
of the above-described well, being first duly sworn on oath, says: That I have knowledge of the facts, statements, and matters herein contained and the log of the above-described well as filed and that the same are true and correct. So help me God.


(Signature)

*[Handwritten Signature]*  
Lakin, Kansas (Address)

SUBSCRIBED AND SWORN TO before me this 2nd day of July, 1979

*[Handwritten Signature]*  
Notary Public.

My commission expires 6-15-81

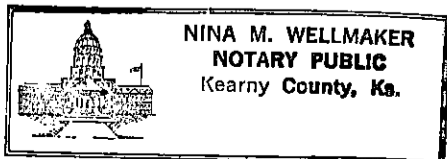



Operator **Dernick, Land & Co. - Remuda Corporation** DESIGNATE TYPE OF COMP.: OIL, GAS, DRY HOLE, SWDW, ETC.:

Well No. **1** Lease Name: **Lunt** Dry Hole

S 30 T 21 SR 39 EX W

**WELL LOG**

Show all important zones of porosity and contents thereof; cored intervals, and all drill-stem tests, including depth interval tested, cushion used, time tool open, flowing and shut-in pressures, and recoveries.

SHOW GEOLOGICAL MARKERS, LOGS RUN, OR OTHER DESCRIPTIVE INFORMATION.

FORMATION DESCRIPTION, CONTENTS, ETC.	TOP	BOTTOM	NAME	DEPTH
Surface Sand & Clay	0	225	Welex GR-ACV	TD to 334'
Blue Shale	225	334		
Blue Shale	334	1319		
Anhydrite Streaks	1319	1333		
Shale & Gyp	1333	1470		
Anhydrite & Shale	1470	1926		
Gyp & Shale	1926	2318		
Anhydrite	2318	2338		
Anhydrite & Shale	2338	2576		
Lime & Shale	2576	2815		
	2815	TD		

USE ADDITIONAL SHEETS, IF NECESSARY

COMPLETE WELL RECORD.

Date Received \_\_\_\_\_

Signature: *R. M. ...*

Title: *Petroleum Engineer*

Date: **June 14, 1979**