


WELL PLUGGING RECORD

Give All Information Completely
Make Required Affidavit
Mail or Deliver Report to:
Conservation Division
State Corporation Commission
800 Biting Building
Wichita, Kansas

NORTH

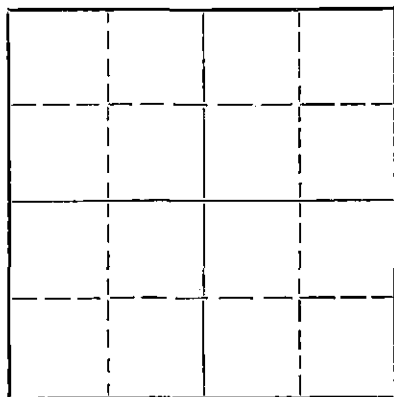

Locate well correctly on above
Section Plat

Barton County. Sec. 26 Twp. 16S Rge. 12 (E) E (WX)
Location as "NE/CNW/SW" or footage from lines C-SE/4 SE/4 NE/4
Lease Owner ELDORADO REFINING CO.
Lease Name Dolecheck Well No. 1
Office Address 1020 Central Bldg., Wichita, Kansas
Character of Well (completed as Oil, Gas or Dry Hole) Dry Hole
Date well completed November 12 19 56
Application for plugging filed _____ 19 _____
Application for plugging approved November 12 19 56
Plugging commenced November 12 19 56
Plugging completed November 12 19 56
Reason for abandonment of well or producing formation No Producing Zones

If a producing well is abandoned, date of last production None 19 _____
Was permission obtained from the Conservation Division or its agents before plugging was commenced? Yes

Name of Conservation Agent who supervised plugging of this well Eldon Petty Hays, Kansas
Producing formation -- Depth to top -- Bottom -- Total Depth of Well 3375 Feet
Show depth and thickness of all water, oil and gas formations.

OIL, GAS OR WATER RECORDS

CASING RECORD

FORMATION	CONTENT	FROM	TO	SIZE	PUT IN	PULLED OUT
				8 5/8" OD	312'	None

Describe in detail the manner in which the well was plugged, indicating where the mud fluid was placed and the method or methods used in introducing it into the hole. If cement or other plugs were used, state the character of same and depth placed, from _____ feet to _____ feet for each plug set.

Mud up with heavy mud to 300', pushed wooden plug to 300', placed 20 sacks cement on plug, through drill pipe. Mud up to 35', pushed wooden plug to 35' with 10 sacks cement to base of well cellar.

(If additional description is necessary, use BACK of this sheet)

Name of Plugging Contractor Garvey Drilling Company
Address R. R. #2 Great Bend, Kansas

STATE OF KANSAS, COUNTY OF BARTON, ss.
Verne A. Morris (employee of owner) or XXXXXXXXXX of the above-described well, being first duly sworn on oath, says: That I have knowledge of the facts, statements, and matters herein contained and the log of the above-described well as filed and that the same are true and correct. So help me God.

(Signature) Verne A. Morris
R. R. #2, Great Bend, Kansas
(Address)

SUBSCRIBED AND SWORN to before me this 15th day of November, 1956

My commission expires November 12, 1958

Bransford
STATE CORP. COM. DIVISION
Notary Public.

PLUGGING
TWP. SEC. 26 T. 16 R. 12 W
COR. PAGE 15 LINE 43

24-7368-6 3-53-20M

STATE CORP. COM. DIVISION
WICHITA, KANSAS

1-2-57

WELL LOG

15-009-00310-00-00

COMPANY ELDORADO REFINING COMPANY

SEC. 26 T. 16S R. 12W

FARM Dolecheck NO. 1


LOC. SE, SE, NE

TOTAL DEPTH 3375'

COUNTY Barton Co., Kansas

COMM. November 3, 1956 COMP. November 12, 1956

CONTRACTOR GARVEY DRILLING COMPANY

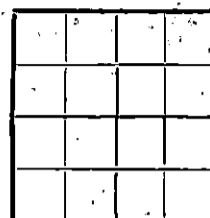

CASING 8 5/8" @ 312' W/200 sax.

ELEVATION 1933' DF

PRODUCTION D & A

FIGURES INDICATE BOTTOM OF FORMATIONS

410	Shale & clay
550	Sand
710	Shale & red bed
765	Red bed
805	Anhydrite
1565	Shale & shells
2742	Lime & shale
3020	Lime
3070	Shale & lime
3105	Lime
3190	Lime & shale
3375	Lime
3375	T. D.

RECEIVED
STATE CORPORATION COMMISSION
JAN 5 1957
CONSERVATION DIVISION
Wichita, Kansas

FORMATION TOPS - Elevation 1935 RB, 1933 DF

Topeka	2728	- 793
Douglas	3005	-1070
Lans/KC	3081	-1146
Arbuckle	Absent	
Reagan Sand	3318	-1383
Granite Wash	3332	-1397
RTD	3375	-1440

State of KANSAS }
County of BARTON } ss:

I, Verne A. Morris of Garvey Drilling Company

upon oath state that the above and foregoing is a true and correct copy of the log of the #1 Dolecheck well

Verne A. Morris

Subscribed and sworn to before me this 15th day of November 19 56

My Commission Expires: November 12, 1958

PLUMBING
FILE SEC. 26 T. 16 R. 12W
BOOK PAGE 115 LINE 42