


Give All Information Completely
Make Required Affidavit
Mail or Deliver Report to:
Conservation Division
State Corporation Commission
211 No. Broadway
Wichita, Kansas

15-009-06008-00-00

WELL PLUGGING RECORD

NORTH

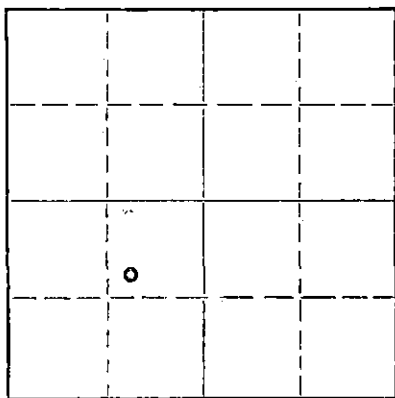

Locate well correctly on above
Section Plat

Barton

County. Sec. 26 Twp. 16 Rge. 12 (X)W (W)

Location as "NE/CNW/SW" or footage from lines.

Lease Owner C. O. Chubb and Duke Drilling Company

Lease Name Dolecheck

Well No. 1

Office Address Box 123 Great Bend, Kansas

Character of Well (completed as Oil, Gas or Dry Hole) Dry Hole

Date well completed 24th, August 19 59

Application for plugging filed 24th, August 19 59

Application for plugging approved 19

Plugging commenced 24th, August 19 59

Plugging completed 24th, August 19 59

Reason for abandonment of well or producing formation

If a producing well is abandoned, date of last production 19

Was permission obtained from the Conservation Division or its agents before plugging was commenced? yes

Name of Conservation Agent who supervised plugging of this well Don Truan

Producing formation Depth to top Bottom Total Depth of Well 3525 Feet

Show depth and thickness of all water, oil and gas formations.

OIL, GAS OR WATER RECORDS

CASING RECORD

FORMATION	CONTENT	FROM	TO	SIZE	PUT IN	PULLED OUT
		0	332	8 5/8		None

Describe in detail the manner in which the well was plugged, indicating where the mud fluid was placed and the method or methods used in introducing it into the hole. If cement or other plugs were used, state the character of same and depth placed, from feet to feet for each plug set.

Filled hole with heavy mud to 300' from top, set wooden plug, 1/2 sack hulls, and 25 sacks wet cement.

Filled hole to 40' from top, set wooden plug, 1/2 sack hulls, and 10 sacks cement filled to base of cellar.

RECEIVED
STATE CORPORATION COMMISSION
AUG 27 1959
CONSERVATION DIVISION
Wichita, Kansas

(If additional description is necessary, use BACK of this sheet)
Name of Plugging Contractor Duke Drilling Company
Address Box 123 Great Bend, Kansas

STATE OF Kansas, COUNTY OF Barton, ss.
Lewis O. Chubb

(employee of owner) or (owner of interest) of the above-described well, being first duly sworn on oath, says: That I have knowledge of the facts, statements, and matters herein contained and the log of the above-described well as filed and that the same are true and correct. So help me God.

(Signature)

Box 123 Great Bend, Kansas

(Address)

SUBSCRIBED AND SWORN to before me this 18th day of August, 19 59

My commission expires June 24, 1963

Chas E. Johnson
Notary Public.

PLUGGING
FILE SEC 26 T. 16 R. 12
BOOK PAGE 63 LINE 19

WELL LOG

Date Started August 13, 1959
 Date Completed August 24, 1959

Dolecheck # 1
 SW NE SW
 Section 26-16S-12W
 Barton County, Kansas

Elevation	1917'	R.B.
Anhydrite	787'	1130
Topeka	2703'	- 786
Heebner	2991'	-1074
Toronto	3007'	-1090
Douglas	3019'	-1102
Iatan	3085'	-1168
Lansing	3104'	-1187
Arbuckle	3361'	-1443
R.T.D.	3425'	-1508

8 5/8" set at 332' with 190 sacks

0' - 162'	Shale
162' - 170'	Sand
170' - 195'	Shale
195' - 200'	Sand
200' - 276'	Shale
276' - 281'	Sand
281' - 332'	Shale
332' - 360'	Shale
360' - 380'	Sand
380' - 465'	Shale
465' - 472'	Sand
472' - 530'	Shale
530' - 600'	Red Bed
600' - 787'	Shale, Shells
787' - 808'	Anhydrite
808' - 1455'	Shale, Shells, Salt
1455' - 2705'	Lime, Shale
2705' - 2832'	Lime - Topeka
2832' - 2911'	Shale, Lime
2911' - 2991'	Lime
2991' - 2995'	Shale - Heebner
2995' - 3007'	Lime, Shale
3007' - 3020'	Lime - Toronto
3020' - 3085'	Shale - Douglas
3085' - 3104'	Lime, Shale - Iatan
3104' - 3336'	Lime - Lansing
3336' - 3361'	Lime, Shale
3361' - 3372'	Dolomite Arbuckle
3372' - 3425'	Chert, Sand, Shale
3425'	R.T.D.

RECEIVED
 STATE CORPORATION COMMISSION

AUG 27 1959

CONSERVATION DIVISION
 Wichita, Kansas

AFFIDAVIT

State of Kansas County of Barton

I, Lewis O. Chubb, employee of the owner, do swear that the statements and matter herein contained are true to the best of my knowledge.

THE DUKE DRILLING COMPANY

By: Lewis O. Chubb

Subscribed and sworn to before me this 26th day of August, 1959.

Chas. E. Stevenson
 Notary Public

My Commission Expires: June 24, 1963.

