

STATE OF KANSAS
STATE CORPORATION COMMISSION

Give All Information Completely
Make Required Affidavit
Mail or Deliver Report to:
Conservation Division
State Corporation Commission
800 Bittling Building
Wichita, Kansas

15-009-06378-00-00

WELL PLUGGING RECORD

OR

FORMATION PLUGGING RECORD

- 1 - State
- 1 - Mr. McCloy
- 3 - Mr. Simms
- 1 - File

Strike out upper line
when reporting plug-
ging off formations.

NORTH

			o

Locate well correctly on above
Section Plat

Barton County. Sec. **26** Twp. **16** Rge. **(E) 12** (W)
 Location as "NE $\frac{1}{4}$ NW $\frac{1}{4}$ SW $\frac{1}{4}$ " or footage from lines **860' fr. So. Line, 330' fr. E. Line of SE $\frac{1}{4}$**
 Lease Owner **Sohio Petroleum Company**
 Lease Name **Harzman** Well No. **1**
 Office Address **Box 609, Russell, Kansas**
 Character of Well (completed as Oil, Gas or Dry Hole) **Dry Hole**
 Date well completed **May 22, 1944** 19.
 Application for plugging filed **May 23, 1944 by telephone-Eldon Petty** 19.
 Application for plugging approved **May 23, 1944 by Eldon Petty, written** 9.
 Plugging commenced **May 23, 1944** 19.
 Plugging completed **May 24, 1944** 19.
 Reason for abandonment of well or producing formation **Dry Hole**

If a producing well is abandoned, date of last production **Dry Hole** 19.

Was permission obtained from the Conservation Division or its agents before plugging was commenced? **Yes, from Eldon Petty, Great Bend, Kansas**

Name of Conservation Agent who supervised plugging of this well **Eldon Petty, Great Bend, Kansas**

Producing formation **None** Depth to top **None** Bottom **None** Total Depth of Well **3483** Feet

Show depth and thickness of all water, oil and gas formations.

OIL, GAS OR WATER RECORDS

CASING RECORD

Formation	Content	From	To	Size	Put In	Pulled Out
No oil or gas from top of hole to bottom.				8 5/8"	522'	None

Describe in detail the manner in which the well was plugged, indicating where the mud fluid was placed and the method or methods used in introducing it into the hole. If cement or other plugs were used, state the character of same and depth placed, from _____ feet to _____ feet for each plug set.



3483' to 500' Heavy Mud

500' to 480' Bridge & Mud

480' to 430' Cement

430' to 25' Bridge & Mud

25' to 5' Cement

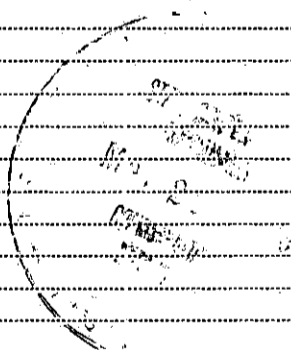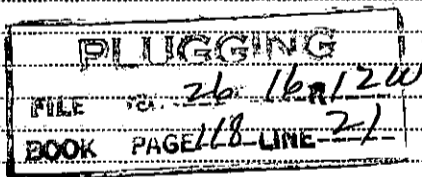

5-29-44

(If additional description is necessary, use BACK of this sheet)

Correspondence regarding this well should be addressed to **Sohio Petroleum Company**

Address **Box 609, Russell, Kansas**

STATE OF **Kansas**, COUNTY OF **Russell**, ss.

Bernie J. Smith (employee of owner) or (conservation agent) of the above-described well,

being first duly sworn on oath, says: That I have knowledge of the facts, statements, and matters herein contained and the log of the above-described well as filed and that the same are true and correct. So help me God.

(Signature) *Bernie J. Smith*

Box 609, Russell, Kansas
(Address)

SUBSCRIBED AND SWORN to before me this **26th** day of **May, 1944**, 19.

My commission expires *July 9, 1944*

15-009-06378-00-00
CONTRACTOR'S VERIFIED LOG

Operator Sohio Petroleum Company Farm Name Hartzman Well No. I
 Location NE/4 SE/4 SW/4 Sec. 26-T16-R12
 Pool Name _____ County Barton State Kansas
 Commencement Date May 1st, 1944 Completion Date May 23rd, 1944

LOG OF WELL

Depth		Formation	Deviation from Vertical (Degrees)	Remarks
From	To			
0	200	Surface Clay-Sand-Shale-Shells		
200	519	Shale-Sand-Shells	1/4°	
519	600	Shale-Shells		
600	1405	Red Rock-Anhydrite-Sand-Shale-Shells	1/4°	Top Anhydrite 792'
1405	1740	Shale-Shells-Broken Lime	0°	
1740	1960	Lime		
1960	2087	Lime-Red Rock-Shale	1/4°	
2087	2140	Lime		Repairing Motor
2140	2390	Lime-Shale-Shells		
2390	2625	Shale-Lime streaks	1/2°	
2625	2770	Shale-Lime		Top Topeka 2738'
2770	2795	Lime		Lost Circulation
2795	2855	Lime		
2855	3000	Lime		
3000	3190	Shale-Broken Lime	6°	Top KC-Lansing 3128'
3190	3325	Lime		
3325	3422	Lime-Shale-Chert-Conglomer-		Top Cong. 3393'
3422	3483	Cong.-Arbuckle Lime (ate	1/2°	Top Arbuckle 3443'. Core #1 3448' to 3453'. Ran Schlumberger.

PLUGGING
 BOOK PAGE 118 LINE 21

