

STATE OF KANSAS
STATE CORPORATION COMMISSION

WELL PLUGGING RECORD


OR

FORMATION PLUGGING RECORD

Strike out upper line
when reporting plug-
ging off formations.

Give All Information Completely
Make Required Affidavit
Mail or Deliver Report to:
Conservation Division
State Corporation Commission
800 Bittling Building
Wichita, Kansas

NORTH

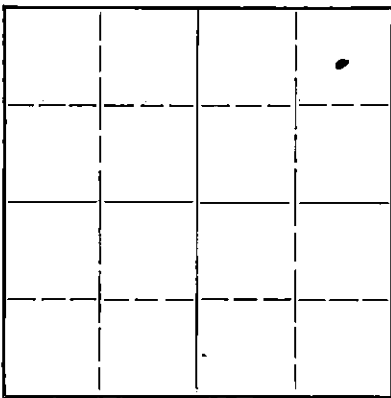

Locate well correctly on above
Section Plat

Barton County. Sec. 26 Twp. 16S Rge. 12 (E) W (W)
Location as "NE $\frac{1}{4}$ NW $\frac{1}{4}$ SW $\frac{1}{4}$ " or footage from lines Ne, NE 1/4
Lease Owner Black Marshall Oil Company
Lease Name Veat Well No. 1
Office Address Great Bend, Kansas
Character of Well (completed as Oil, Gas or Dry Hole) Dry Hole
Date well completed January 15th, 1944 19 44
Application for plugging filed January 15th 19 44
Application for plugging approved January 15th 19 44
Plugging commenced January 15th 1944 19
Plugging completed January 16th 1944 19
Reason for abandonment of well or producing formation Dry Hole

If a producing well is abandoned, date of last production 19
Was permission obtained from the Conservation Division or its agents before plugging was com-
menced? Yes

Name of Conservation Agent who supervised plugging of this well C.T. Alexander, Great Bend, Kansas
Producing formation None Depth to top Bottom Total Depth of Well 3400' Feet
Show depth and thickness of all water, oil and gas formations.


OIL, GAS OR WATER RECORDS

CASING RECORD

Formation	Content	From	To	Size	Put In	Pulled Out
<u>Dakota Sand</u>	<u>Water</u>	<u>410</u>	<u>483</u>	<u>6 3/4"</u>	<u>None</u>	
				<u>8 5/8"</u>	<u>272'</u>	<u>Cemented</u>

Describe in detail the manner in which the well was plugged, indicating where the mud fluid was placed and the method or methods used in introducing it into the hold. If cement or other plugs were used, state the character of same and depth placed, from feet to feet for each plug set.

The hole was circulated with heavy mud and filled up with heavy mud to 272' where a wooden plug was set and the hole bridged, and 17 sacks of cement were pumped down top of the plug, the hole was then filled with heavy mud to 26', where a bridge was set and cemented with 4 sacks of cement bringing it up to the bottom of the cellar, and the bottom of cellar was cemented.

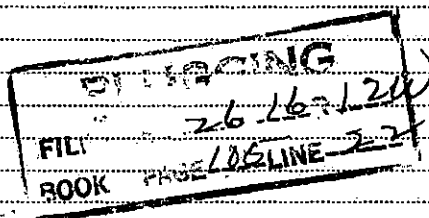

(If additional description is necessary, use BACK of this sheet)

Correspondence regarding this well should be addressed to Black Marshall Oil Company
Address Great Bend, Kansas

STATE OF Kansas COUNTY OF Barton, ss.
Walter C. Roberts (employee of owner) or (owner or operator) of the above-described well,
being first duly sworn on oath, says: That I have knowledge of the facts, statements, and matters herein contained and the log of the above-described well as filed and that the same are true and correct. So help me God.

(Signature) Walter C Roberts
Clifton Kansas
(Address)

SUBSCRIBED AND SWORN TO before me this 18 day of January, 1944.

My commission expires Feb. 5 1947 Edwin Woydzak Notary Public.



15-009-06564-00-00

BLACK-MARSHALL OIL COMPANY

#1 Veat Dolechek (Dry & Abandoned)

NE $\frac{1}{4}$ NE $\frac{1}{4}$ NE $\frac{1}{4}$ of
Sec. 26-16S-12W
County: Barton

Elevation: 1924

Total Depth: 3400'

Comm: 1-3-44

Comp: 1-15-44

CASING

8 5/8" 272'

Cellar	0	4'
Shale & Shells	4	185'
Shale & Shells	185	410
Sand	410	483
Shale & Shells	483	520
Red Rock	520	785
Anhydrate	785	815
Shale & Shells	815	1220
Salt	1220	1500
Shale & Shells	1500	1805
Lime & Sh. Brks.	1805	2070
Shale & Shells	2070	2685
Lime	2685	3020
Shale	3020	3054
Lime	3054	3060
Shale	3060	3082
Lime	3082	3340
Shale & Lime	3340	3349
Sand	3349	3352
Sandy Shale	3352	3357
Sandy Conglomerate	3357	3400

