

STATE OF KANSAS  
STATE CORPORATION COMMISSION

Form CP-4

Give All Information Completely  
Make Required Affidavit  
Mail or Deliver Report to:  
Conservation Division  
State Corporation Commission  
212 No. Market  
Wichita, Kansas

WELL PLUGGING RECORD

Stafford County, Sec. 20 Twp. 21S Rge. 13 (E) 13 (W)

Location as "NE/CNW/SW" or footage from lines NW SW NW

Lease Owner Aspen Drilling Co.

Lease Name Walter Well No. 1

Office Address P. O. Box 783, Great Bend, Kansas

Character of Well (completed as Oil, Gas or Dry Hole) Dry Hole

Date well completed September 4 19 68

Application for plugging filed 19         

Application for plugging approved 19         


Plugging commenced September 3 19 68

Plugging completed September 4 19 68

Reason for abandonment of well or producing formation Dry Hole

If a producing well is abandoned, date of last production 19         

Was permission obtained from the Conservation Division or its agents before plugging was commenced? yes

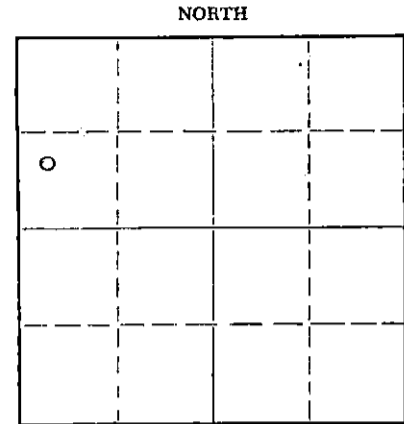

Locate well correctly on above Section Plat

Name of Conservation Agent who supervised plugging of this well Ralph Warren

Producing formation          Depth to top          Bottom          Total Depth of Well 3781 Feet

Show depth and thickness of all water, oil and gas formations.

OIL, GAS OR WATER RECORDS

CASING RECORD

FORMATION	CONTENT	FROM	TO	SIZE	PUT IN	PULLED OUT

Describe in detail the manner in which the well was plugged, indicating where the mud fluid was placed and the method or methods used in introducing it into the hole. If cement or other plugs were used, state the character of same and depth placed, from          feet to          feet for each plug set.

Pushed plug to 250 ft. Dumped 15 ft. rock, 5 sacks cement and 1 sack Calseal.

Pushed plug to 227 ft. in surface pipe, dumped 3 3/4 yds ready-mix concrete.

RECEIVED  
STATE CORPORATION COMMISSION  
DEC 2 1968  
CONSERVATION DIVISION  
Wichita, Kansas

(If additional description is necessary, use BACK of this sheet)

Name of Plugging Contractor ~~XXXXXXXXXX~~ Pawnee Drilling Co.

Address P. O. Box 783, Great Bend, Kansas

STATE OF Kansas, COUNTY OF Barton, ss.

Robert L. Pelster (employee of owner) or (owner or operator) of the above-described well, being first duly sworn on oath, says: That I have knowledge of the facts, statements, and matters herein contained and the log of the above-described well as filed and that the same are true and correct. So help me God.


(Signature) Robert L. Pelster

P. O. Box 783, Great Bend, Kansas  
(Address)

Subscribed and sworn to before me this 26th day of November, 1968

My commission expires April 18, 1972

Theora Holleman  
Notary Public.

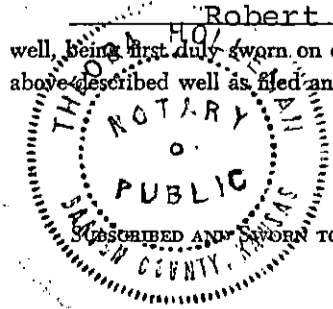

RECEIVED  
STATE CORPORATION COMMISSION  
AUG 21 1968  
CONSERVATION DIVISION  
Wichita, Kansas

D R I L L E R S      L O G

COMPANY: Aspen Drilling Co.  
 CONTRACTOR: Aspen Drilling Co.  
 LEASE NAME: Walter #1  
 LOCATION: NW SW NW Sec.20-T21S-R13W  
 Stafford County, Kansas  
 1911 KB  
 ELEVATION: 8 jts.(322') 8 5/8"  
 SURFACE CASING: 119 jts.(3755') 5 1/2"  
 OIL STRING: 7-13-68  
 COMMENCED: 7-20-68  
 COMPLETED: 3750'  
 ROTARY TOTAL DEPTH:

<u>FORMATION</u>	<u>DEPTH</u>	
Shale & Red Bed	950	Ran 8 jts.(322') 8 5/8", set at
Shale	1645	330', cemented with 300 sacks.
Shale-Shells	1700	Cement circulated.
Lime-shale	2310	
Shale-Lime	3030	DST #1      3744-3750
Lime	3235	
Lime-Shale	3390	Ran 119 jts.(3755') used 14 1/2#
Lime	3750	casing, set at 3744', cemented
		with 50 sacks.

AFFIDAVIT

State of Kansas      )  
                                   ) ss:  
 County of Barton    )

The undersigned, being duly sworn on oath, states that the above statement and log are a true and correct record and log of the well drilled at the location above described.

*William S. Schachle*  
 \_\_\_\_\_  
 William S. Schachle

Subscribed and sworn to before me this 24th day of July, 1968.



*Theora Holleman*  
 \_\_\_\_\_  
 Theora Holleman, Notary Public

My commission expires: April 18, 1972