


WELL PLUGGING RECORD

Give All Information Completely
Make Required Affidavit
Mail or Deliver Report to:
Conservation Division
State Corporation Commission
212 North Market, Insurance Bldg.
Wichita, Kansas

STAFFORD

County. Sec. 20 Twp. 21s Rge. 13 ~~(#)~~ (W)

Location as "NE/CNWxSWx" or footage from lines NW NE SE
Lease Owner PETROLEUM, INC.
Lease Name HARMS "D" Well No. 1
Office Address ROUTE 2, GREAT BEND, KANSAS
Character of Well (completed as Oil, Gas or Dry Hole) DRY HOLE
Date well completed MARCH 1 19 61
Application for plugging filed MARCH 1 19 61
Application for plugging approved MARCH 1 19 61
Plugging commenced MARCH 1 19 61
Plugging completed MARCH 2 19 61
Reason for abandonment of well or producing formation NO PRODUCIBLE ZONES

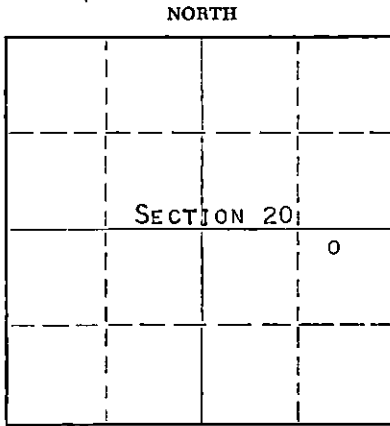

Locate well correctly on above Section Plat

If a producing well is abandoned, date of last production ----- 19 ---
Was permission obtained from the Conservation Division or its agents before plugging was commenced? YES

Name of Conservation Agent who supervised plugging of this well FRANK BROADFOOT, ST. JOHN, KANSAS
Producing formation ----- Depth to top ----- Bottom ----- Total Depth of Well 3421 Feet
Show depth and thickness of all water, oil and gas formations.

OIL, GAS OR WATER RECORDS

CASING RECORD

FORMATION	CONTENT	FROM	TO	SIZE	PUT IN	PULLED OUT
				8-5/8"	223'	NONE

Describe in detail the manner in which the well was plugged, indicating where the mud fluid was placed and the method or methods used in introducing it into the hole. If cement or other plugs were used, state the character of same and depth placed, from ----- feet to ----- feet for each plug set.

MUDDED UP WITH HEAVY MUD TO 200' FOLLOWED BY A WOODEN PLUG AND 1/4 SACK OF HULLS. PLACED 20 SACKS OF CEMENT ON TOP OF HULLS THROUGH DRILL PIPE, MUDDED UP WITH HEAVY MUD TO 35' FOLLOWED BY A WOODEN PLUG AND 1/4 SACK OF HULLS. PLACED 10 SACKS OF CEMENT ON TOP OF HULLS TO BASE OF WELL CELLAR.

RECEIVED
STATE CORPORATION COMMISSION

MAR 29 1961 3-29-61

CONSERVATION DIVISION
Wichita, Kansas

(If additional description is necessary, use BACK of this sheet)

Name of Plugging Contractor GARVEY DRILLING COMPANY
Address ROUTE 2, GREAT BEND, KANSAS

STATE OF KANSAS, COUNTY OF BARTON, ss.
DON SEARLE (employee of owner) or (~~owner~~) of the above-described well, being first duly sworn on oath, says: That I have knowledge of the facts, statements, and matters herein contained and the log of the above-described well as filed and that the same are true and correct. So help me God.

(Signature) Don Searle
ROUTE 2, GREAT BEND, KANSAS
(Address)

SUBSCRIBED AND SWORN TO before me this 25TH day of MARCH, 19 61

My commission expires APRIL 14, 1963 Arthur J. Miles Notary Public.



WELL LOG 15.185.19495.0000

COMPANY PETROLEUM, INCORPORATED

SEC. 20 T. 21S R. 13W

FARM HARMS "D" NO. 1


LOC. NW, NE, SE

TOTAL DEPTH 3421'

COUNTY STAFFORD CO., KANSAS

COMM. February 23, 1961 COMP. March 2, 1961

CONTRACTOR GARVEY DRILLING COMPANY

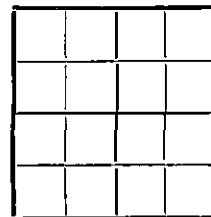

CASING 8-5/8" @ 223' w/250 sax.

ELEVATION 1905' DF

PRODUCTION D & A

FIGURES INDICATE BOTTOM OF FORMATIONS

97	Sand & gravel
110	Hard sand
223	Shale & sand
780	Red bed & shale
810	Anhydrite
1200	Shale & shells
1785	Shale & sand
2110	Lime & shale
2788	Shale & lime
3105	Lime & shale
3135	Lime
3250	Lime & shale
3421	Lime
3421	T. D.

RECEIVED
STATE CORPORATION COMMISSION

MAR 29 1961

CONSERVATION DIVISION
Wichita, Kansas

State of KANSAS }
County of BARTON } ss.

I, VERNE A. MORRIS of GARVEY DRILLING COMPANY

upon oath state that the above and foregoing is a true and correct copy of the log of the #1 HARMS "D" well

Verne A. Morris

Subscribed and sworn to before me this 24th day of March 19 61

My Commission Expires: November 12, 1962

Brantley
NOTARY PUBLIC