


STATE OF KANSAS
STATE CORPORATION COMMISSION

WELL PLUGGING RECORD

Give All Information Completely
Make Required Affidavit
Mail or Deliver Report to
Conservation Division
State Corporation Comm.
245 North Water
Wichita, KS 67202

Stafford County, Sec. 2 Twp. 21S Rge. 13 N/W
Location as "NE/CNW $\frac{1}{4}$ SW $\frac{1}{4}$ " or footage from lines _____
NW/4 NE/4 SW/4
Lease Owner American Energies Corporation
Lease Name _____ Address _____ Well No. I
Office Address 575 4th Financial Center, Wichita, KS
Character of Well (Completed as Oil, Gas or Dry Hole) _____
dry hole

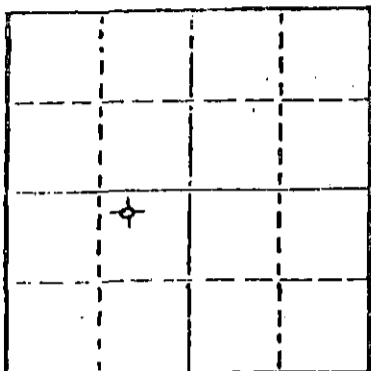

Locate well correctly on above
Section Plot

Date Well completed _____ 12/02/1981
Application for plugging filed _____ 12/02/1981
Application for plugging approved _____ 12/02/1981
Plugging commenced _____ 12/02/1981
Plugging completed _____ 12/02/1981
Reason for abandonment of well or producing formation _____
No commercial quantity of oil or gas encountered.
If a producing well is abandoned, date of last production _____
_____ 19 _____

Was permission obtained from the Conservation Division or
its agents before plugging was commenced? yes

Name of Conservation Agent who supervised plugging of this well Mr. J. H. Metz
Producing formation _____ Depth to top _____ Bottom _____ Total Depth of Well _____
Show depth and thickness of all water, oil and gas formations.

OIL, GAS OR WATER RECORDS

CASING RECORD

FORMATION	CONTENT	FROM	TO	SIZE	PUT IN	PULLED OUT

Describe in detail the manner in which the well was plugged, indicating where the mud fluid
was placed and the method or methods used in introducing it into the hold. If cement or other
plugs were used, state the character of same and depth placed, from _____ feet to
_____ feet for each plug set.

Total Depth 3615 feet. Set first plug at 600 feet with 70 sacks 50/50 posmix
cement, 3% Gel, 2% Calcium Chloride; second plug at 270 feet with 40 sacks;
10 sacks and bridge at 40 feet and 10 sacks in the rat hole. Completed at
2:30 a.m. on December 3, 1981. State Plugger - J. H. Metz.

(If additional description is necessary, use BACK of this sheet)

Name of Plugging Contractor Kaw Drilling Co., Inc.


STATE OF KANSAS COUNTY OF SEDGWICK, ss. contractor
K.S. Martin, President of Kaw Drilling Co., Inc. (~~employee of owner~~)
of the above-described well, being first duly sworn on oath, says: That I have knowledge of
the facts, statements, and matters herein contained and the log of the above-described well
as filed and that the same are true and correct. So help me God.

(Signature) [Signature]
K. S. Martin, President 1010 Union Center
(Address) Wichita, KS 67202

SUBSCRIBED AND SWORN TO before me this 7th day of December, 1981.

My commission expires December 10, 1983

[Signature]
Mary Susan Whaley Notary Public

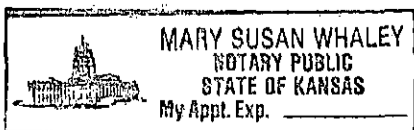

RECEIVED
STATE CORPORATION COMMISSION
DEC - 8 1981
CONSERVATION DIVISION
Wichita, Kansas
15-2-8-81

15.185.21470.0000

OPERATOR:	American Energies Corporation
CONTRACTOR:	Kaw Drilling Co., Inc.
WELL NAME:	Address #1
LOCATION:	NW NE SW Sec. 2-21S-13W Stafford County, Kansas
SPUD DATE:	November 24, 1981
COMPLETION DATE:	December 2, 1981


0	1618	Shell and Shale
1618	2018	Shale
2018	2285	Shell and Shale
2285	2552	Shell and Lime Streaks
2552	3296	Shale
3296	3615	Lime
	3615	R.T.D.

Spud hole at 5:50 p.m. on November 24, 1981. Drilled 254 feet of 12½ inch hole. Ran 6 joints of 8 5/8 inch, 23 pound new surface casing. (Tallied at 239.68 feet.) Set at 251 feet with 175 sacks common cement, 3% Gel and 2% calcium chloride. Plug was down at 11:00 p.m. on November 24, 1981.

Total Depth 3615 feet. Set first plug at 600 feet with 70 sacks 50/50 posmix cement, 3% Gel and 2% calcium chloride; second plug at 270 feet with 40 sacks; 10 sacks and bridge at 40 feet and 10 sacks in the rat hole. Completed at 2:30 a.m. on December 2, 1981. State Plugger - Mr. J. H. Metz.

STATE OF KANSAS)
) ss
COUNTY OF SEDGWICK)


I, K. S. Martin, President of Kaw Drilling Co., Inc., being first duly sworn and upon my oath, state that: I have knowledge of the facts, statements and matters herein contained and the log of the above described well as filed and that the same are true and correct. So help me God.

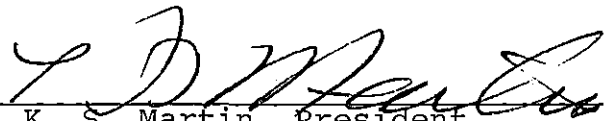
K. S. Martin, President

SUBSCRIBED AND SWORN to before me on this 7th day of December, 1981.


Mary Susan Whaley, Notary Public

My Commission Expires:
December 10, 1983

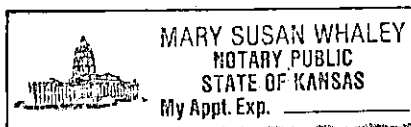

STATE CORPORATION
DEC - 8 1981
CONSERVATION DIVISION
Wichita, Kansas