


STATE OF KANSAS
STATE CORPORATION COMMISSION

WELL PLUGGING RECORD

Give All Information Completely
Make Required Affidavit
Mail or Deliver Report to
Conservation Division
State Corporation Comm.
245 North Water
Wichita, KS 67202

Stafford County, Sec. 2 Twp. 21S Rge. 13 E/W
Location as "NE/CNW $\frac{1}{4}$ /SW $\frac{1}{4}$ " or footage from lines

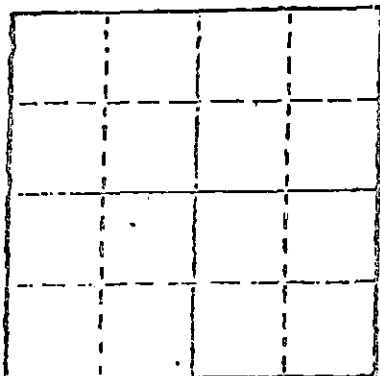

Locate well correctly on above
Section Plat

NE SE SE
Lease Owner Centennial Petroleum, Inc.
Lease Name East Prairie Home (Address) Well No. 1
Office Address Suite 1415, Denver Club Bldg., 518 17th St.,
Character of Well (Completed as Oil, Gas or Dry Hole)
Dry Hole Denver, CO 80202

Date Well completed 5-19 1981
Application for plugging filed 5-19 1981
Application for plugging approved 5-19 1981
Plugging commenced 5-19 1981
Plugging completed 5-19 1981
Reason for abandonment of well or producing formation

Dry Hole
If a producing well is abandoned, date of last production 19

Was permission obtained from the Conservation Division or
its agents before plugging was commenced? yes

Name of Conservation Agent who supervised plugging of this well William T. Owen
Producing formation Depth to top Bottom Total Depth of Well

Show depth and thickness of all water, oil and gas formations.

OIL, GAS OR WATER RECORDS

CASING RECORD

FORMATION	CONTENT	FROM	TO	SIZE	PUT IN	PULLED OUT
				8-5/8"	213'	-0-

Describe in detail the manner in which the well was plugged, indicating where the mud fluid
was placed and the method or methods used in introducing it into the hold. If cement or other
plugs were used, state the character of same and depth placed, from feet to
feet for each plug set.

Mud laden fluid 3560' - 520'
50 sks cement @ 520'
30 sks cement @ 215'
10 sks cement @ 40'
10 sks cement in rat hole.

RECEIVED 5-27-81
STATE CORPORATION COMMISSION

MAY 27 1981

(If additional description is necessary, use BACK of this sheet)

Name of Plugging Contractor Emphasis Oil Operations

STATE OF KANSAS COUNTY OF RUSSELL, ss.
Joe K. Branum (employee of owner) or (owner or operator)
of the above-described well, being first duly sworn on oath, says: That I have knowledge of
the facts, statements, and matters herein contained and the log of the above-described well
as filed and that the same are true and correct. So help me God.

(Signature) Joe K. Branum
P. O. Box 506, Russell, KS 67665
(Address)

SUBSCRIBED AND SWORN TO before me this 26th day of May, 1981.

Glenda R. Tiffin
Glenda R. Tiffin Notary Public.

My commission expires February 6, 1984.



EMPHASIS OIL OPERATIONS

P. O. Box 506
Russell, Kansas 67665

DRILLERS LOG

OPERATOR: Centennial Petroleum, Inc.
Suite 1415, Denver Club Building
518 Seventeenth Street
Denver, Colorado 80202

CONTRACTOR: Emphasis Oil Operations
P. O. Box 506
Russell, Kansas 67665

LEASE: East Prairie Home (Address)
WELL: #1

LOCATION: NE SE SE
Section 2-21S-13W
Stafford County, Kansas

Total Depth: 3560'

Elevation:

Commenced: 5-7-81

Completed: 5-19-81

Casing: 8-5/8" @ 213' with 175 sks cement

Status: Dry Hole

DEPTHS & FORMATIONS

(All measurements from K.B.)

Top Soil & Sand	40'	Lime & Shale	2738'
Clay & Sand	330'	Lime	2792'
Sand & Shale	1546'	Lime & Shale	3486'
Shale	2448'	Lime (R.T.D.)	3560'

RECEIVED
STATE OF KANSAS COMMISSION
MAY 7 1981
COMMISSION DIVISION
Wichita, Kansas

STATE OF KANSAS)
) ss:
COUNTY OF RUSSELL)

I, Joe K. Branum, of Emphasis Oil Operations, state that the above and foregoing is a true and correct log of the above captioned well.

Joe K. Branum

Joe K. Branum

Subscribed and sworn to before me this 26th day of May, 1981.
My Commission Expires: February 6, 1984.

 **GLEND A. R. TIFFIN**
Russell County, Ks.
My Appt. Exp. 2-6-84

Glenda R. Tiffin

Notary Public