


WELL PLUGGING RECORD

Give All Information Completely  
Make Required Affidavit  
Mail or Deliver Report to:  
Conservation Division  
State Corporation Commission  
800 Bittling Building  
Wichita, Kansas

Stafford County. Sec. 2 Twp. 21 Rge. (E) 13 (W)  
Location as "NE/CNW $\frac{1}{4}$ /SW $\frac{1}{4}$ " or footage from lines SE SW NW $\frac{1}{4}$   
Lease Owner: Armer Drilling Company, Inc.  
Lease Name: Address "D" Well No. 1  
Office Address: 306 Insurance Bldg., Wichita 2, Kansas  
Character of Well (completed as Oil, Gas or Dry Hole) dry  
Date well completed: October 10 19 49  
Application for plugging filed: November 1 19 49  
Application for plugging approved: November 1 19 49  
Plugging commenced: November 3 19 49  
Plugging completed: November 8 19 49  
Reason for abandonment of well or producing formation: dry

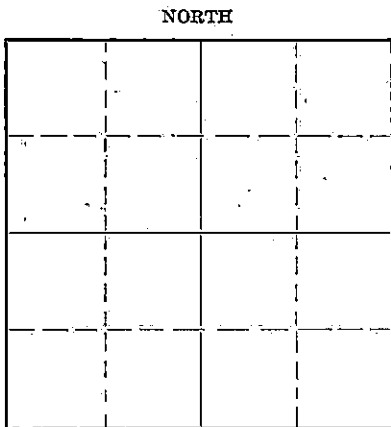

Locate well correctly on above  
Section Plat

If a producing well is abandoned, date of last production 19  
Was permission obtained from the Conservation Division or its agents before plugging was commenced? yes

Name of Conservation Agent who supervised plugging of this well: C. D. Stough  
Producing formation: Arbuckle (dry) Depth to top: 3527 Bottom: 3600 Total Depth of Well: 3600 Feet  
Show depth and thickness of all water, oil and gas formations.

OIL, GAS OR WATER RECORDS

CASING RECORD

Formation	Content	From	To	Size	Put In	Pulled Out
Arbuckle	dry	3527	3600	8-5/8" 5 1/2"	212' 3539'	none 2847'

Describe in detail the manner in which the well was plugged, indicating where the mud fluid was placed and the method or methods used in introducing it into the hole. If cement or other plugs were used, state the character of same and depth placed, from \_\_\_\_\_ feet to \_\_\_\_\_ feet for each plug set.

Plug back from 3600 ft. to 3392 ft. with mud, and Lane-Wells plug, filled with chat from 3392 ft. to 3375 ft. and dumped 5 sacks cement at 3375 ft. Ripped off and pulled 5 1/2" casing, filled with mud to 215 ft., set rock bridge and 15 sacks cement at 215 ft. and ~~set~~ mudded to 30 ft. and set bridge and 10 sacks cement at surface.

NOV 18 1949

11-18-49

STATE CORPORATION COMMISSION

KANSAS

(If additional description is necessary, use BACK of this sheet)

Correspondence regarding this well should be addressed to: Armer Drilling Company, Inc.  
Address: 306 Insurance Bldg., Wichita 2, Kansas

STATE OF Kansas COUNTY OF Sedgwick ss.  
L. C. Sponenberg (employee of owner) or (owner or operator) of the above-described well, being first duly sworn on oath, says: That I have knowledge of the facts, statements, and matters herein contained and the log of the above-described well as filed and that the same are true and correct. So help me God. ARMER DRILLING COMPANY, INC.


(Signature) *L. C. Sponenberg*  
Secretary

(Address) \_\_\_\_\_

SUBSCRIBED AND SWORN to before me this 17th day of November, 19 49

*Nazel Walton*  
Notary Public.

My commission expires Sept. 17, 1951

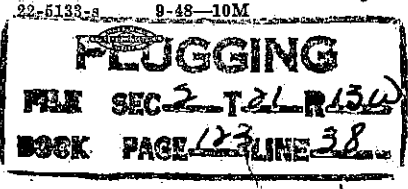

L O O

OWNER: M. B. Armer et al  
CONTRACTOR: Armer Drilling Company, Inc.  
DRILLING COMMENCED: 9/15/49  
DRILLING COMPLETED: 9/30/49  
ELEVATION: 1873 D. F.  
1870 Cr.  
(Rotary #1)

FAC# Address "D" #1  
LOCATION: BK 8- N 2-215-13N,  
Stefford County, Kansas  
CASING RECORD: 8-5/8" set @ 212'  
cemented with 125 sacks cement  
5/8" set @ 3539' cemented with  
100 sacks cement.

(figures below indicate bottoms)

Sand	40
Sand, shale and shells	212
Shale & lime	250
Shale & shells	310
Red bed	695
Anhydrite	720
Shale & shells	1000
Shale & lime	1165
Shale & shells	1270
Salt	1300
Shale & shells	1515
Shale & lime	2045
Lime	3102
Lime & shale	3225
Lime	3500
Shale	3527
Dolomite & shale	3547
Total Depth - rotary	3547

FORMATION TOPS: (all measurements RB)

Hestner	3117
Lansing	3256
Conglomerate	3502
Arbuckle	3527

I hereby certify that this is a true and correct log of the above described well as shown by the drilling reports.

ARMER DRILLING COMPANY, INC.

By *R. C. Spurr*

STATE OF KANSAS }  
COUNTY OF SEDGWICK } SS

Subscribed and sworn to before me, a notary public, in and for said County and State this 4th day of October, 1949.

*Harold Walton*  
Notary Public

My commission expires Sept. 17, 1951.

NOV 18 1949

STATE REGULATION  
COMMISSION  
KANSAS

**PLUGGING**  
FILE SEC. 2 T 21 R 130  
BOOK PAGE 123 LINE 38