


STATE OF KANSAS  
STATE CORPORATION COMMISSION

WELL PLUGGING RECORD

Give All Information Completely  
Make Required Affidavit  
Mail or Deliver Report to:  
Conservation Division  
State Corporation Commission  
211 No. Broadway  
Wichita, Kansas

Stafford County. Sec. 2 Twp. 21S Rge. 13W(E) (W)

NORTH

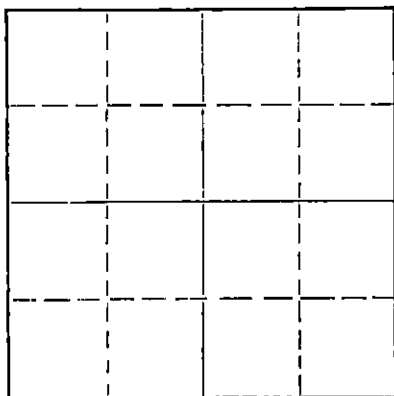

Locate well correctly on above  
Section Plat

Location as "NE/CNW/SW" or footage from lines SW SW NW  
Lease Owner ALPINE OIL & ROYALTY CO., INC.  
Lease Name ADDRESS NO. 1-B Well No.  
Office Address 800 Bitting Building, Wichita, Ks.  
Character of Well (completed as Oil, Gas or Dry Hole) dry hole  
Date well completed April 18, 1962 19  
Application for plugging filed April 18, 1962 19  
Application for plugging approved April 18, 1962 19  
Plugging commenced April 18, 1962 19  
Plugging completed April 18, 1962 19  
Reason for abandonment of well or producing formation non-productive

If a producing well is abandoned, date of last production 19  
Was permission obtained from the Conservation Division or its agents before plugging was commenced? yes

Name of Conservation Agent who supervised plugging of this well W. L. Lac Kamp  
Producing formation Depth to top Bottom Total Depth of Well 3574 Feet  
Show depth and thickness of all water, oil and gas formations.

OIL, GAS OR WATER RECORDS

CASING RECORD

FORMATION	CONTENT	FROM	TO	SIZE	PUT IN	PULLED OUT
				8 5/8"	226'	cemented

Describe in detail the manner in which the well was plugged, indicating where the mud fluid was placed and the method or methods used in introducing it into the hole. If cement or other plugs were used, state the character of same and depth placed, from feet to feet for each plug set.

Heavy mud from total depth to 220 feet  
solid plug and 20 sacks cement through  
drill pipe mud to 40 feet another solid plug  
and 15 sacks cement

RECEIVED  
STATE CORPORATION COMMISSION

MAR 26 1963

CONSERVATION DIVISION

(If additional description is necessary, use BACK of this sheet)

Name of Plugging Contractor Quaker Drilling Co., Inc.  
Address 800 Bitting Bldg., Wichita, Ks.

STATE OF Kansas COUNTY OF Sedgwick ss.  
Thomas M. McCaul (employee of owner) or (owner or operator) of the above-described well, being first duly sworn on oath, says: That I have knowledge of the facts, statements, and matters herein contained and the log of the above-described well as filed and that the same are true and correct. So help me God.

(Signature) *Thomas M. McCaul*  
800 Bitting Bldg, Wichita, Ks. (Address)

SUBSCRIBED AND SWORN TO before me this 26th day of April, 1962

My commission expires August 10, 1965 Notary Public.



## WELL LOG

ALPINE OIL &amp; ROYALTY CO., INC.

Commenced: April 10, 1962

Contractor: Quaker Drilling Co., Inc.

Completed: April 18, 1962

Address No. 1-B  
 SW SW NW Sec. 2-21S-13W  
 Stafford County, Kansas

Elevation: 1877 KB

Production: D &amp; A

## Casing Record

8 5/8 inch casing set at 226 feet with 250 sacks cement

(Figures Indicate the Bottom of the Formations)

<u>FORMATION</u>	<u>DEPTH</u>	<u>FORMATION TOPS</u>	
Sand	165	Heebner	3123 -1246
Shale	226	Brown Lime	3246 -1369
Red Bed, Shale & Sand	705	Lansing	3260 -1383
Anhydrite	733	Conglomerate	3503 -1626
Shale and Shells	1350	Arbuckle	3544 -1667
Shale and Sandy Lime	1705	Rotary Total Depth	3574 -1697
Lime and Shale	1860		
Lime	2025		
Shale and Shells	2475		
Shale	2670		
Lime and Shale	2805		
Lime	3120		
Lime and Shale	3574		

RECEIVED  
 STATE OF KANSAS DIVISION OF OIL AND GAS COMMISSION

MAR 26 1963

RECEIVED  
 DIVISION OF OIL AND GAS  

We hereby certify the foregoing to be a true and correct copy of the driller's log of the well drilled in the SW SW NW of Section 2, Township 21 South, Range 13 West, Stafford County, Kansas.

QUAKER DRILLING CO., INC.

By:

*Thomas M. McCaul*  
 Thomas M. McCaul, President

SUBSCRIBED AND SWORN TO BEFORE me a Notary Public this 26th day of April, 1962.

*Virginia Mundell*  
 Virginia Mundell, Notary Public

MY COMMISSION EXPIRES:  
 August 10, 1965