


Give All Information Completely
Make Required Affidavit
Mail or Deliver Report to:
Conservation Division
State Corporation Commission
211 No. Broadway
Wichita, Kansas

WELL PLUGGING RECORD

Hodgeman County. Sec. 9 Twp. 21S Rge. (E) 23 (W)

NORTH

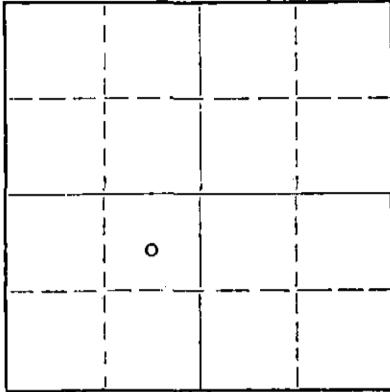

Locate well correctly on above
Section Plat

Location as "NE/CNW/SW" or footage from lines c NE SW
Lease Owner Halliburton Oil Producing Co.
Lease Name Frusher Well No. 1
Office Address 117 Cameron Bldg., Oklahoma City, Okla. 73106
Character of Well (completed as Oil, Gas or Dry Hole) Dry Hole
Date well completed December 9 19 72
Application for plugging filed December 9 19 72
Application for plugging approved December 9 19 72
Plugging commenced December 9 19 72
Plugging completed December 9 19 72
Reason for abandonment of well or producing formation Dry Hole

If a producing well is abandoned, date of last production 19
Was permission obtained from the Conservation Division or its agents before plugging was commenced? Yes

Name of Conservation Agent who supervised plugging of this well Edgar J. Eves
Producing formation Depth to top Bottom Total Depth of Well 2650 Feet
Show depth and thickness of all water, oil and gas formations.

OIL, GAS OR WATER RECORDS

CASING RECORD

| FORMATION | CONTENT | FROM | TO | SIZE | PUT IN | PULLED OUT |
|-----------|---------|------|------|--------|--------|------------|
| | | 0 | 326' | 8 5/8" | 326' | None |
| | | | | | | |
| | | | | | | |
| | | | | | | |
| | | | | | | |
| | | | | | | |
| | | | | | | |

Describe in detail the manner in which the well was plugged, indicating where the mud fluid was placed and the method or methods used in introducing it into the hole. If cement or other plugs were used, state the character of same and depth placed, from feet to feet for each plug set.

Plug:

- 800' w/80 sacks cement
- 300' w/30 sacks cement
- 45' w/15 sacks cement

RECEIVED
STATE CORPORATION COMMISSION

DEC 15 1972

CONSERVATION DIVISION
Wichita, Kansas

(If additional description is necessary, use BACK of this sheet)


Name of Plugging Contractor Hellar Drilling Company, Inc.
Address 339 Union Center Bldg., Wichita, Kansas 67202

STATE OF Kansas COUNTY OF Sedgwick, ss.
D. L. Hellar, President of Hellar Drlg. Co. Inc. (employee of owner) or (owner or operator) of the above-described

well, being first duly sworn on oath, says: That I have knowledge of the facts, statements, and matters herein contained and the log of the above-described well as filed and that the same are true and correct. So help me God.

(Signature) D. L. Hellar, President
339 Union Center Bldg., Wichita, Kansas 67202
(Address)

SUBSCRIBED AND SWORN TO before me this 14th day of December, 19 72

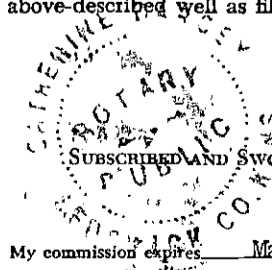

Catherine Darcey
Notary Public.

My commission expires March 25, 1976.

DRILLER'S LOG

COMPANY: Halliburton Oil Producing Co., 117 Cameron Bldg., Okla. City, Okla. 73106
 CONTRACTOR: Hellar Drilling Company, Inc., 339 Union Center Bldg., Wichita, Kansas 67202
 LEASE: #1 Frusher
 LOCATION: c NE SW 9-21S-23W, Hodgeman County, Kansas
 COMMENCED: December 6, 1972
 COMPLETED: December 9, 1972
 CASING: Set 8 5/8" Surface Casing @ 326' w/225 sacks cement

| | |
|-----------|----------------------------------|
| 0-80 | Surface Soil & Post Rock & Shale |
| 80-326 | Post Rock & Shale & Sand |
| 326-1048 | Shale & Sand & Red Bed |
| 1048-1417 | Sand |
| 1417-1559 | Shale |
| 1559-1604 | Anhydrite |
| 1604-1925 | Shale |
| 1925-2516 | Salt Section |
| 2516-2650 | Shale & Lime |
| 2650 | Rotary Total Depth |

D & A

RECEIVED
 STATE CORPORATION COMMISSION
 DEC 15 1972
 CONSERVATION DIVISION
 Wichita, Kansas

STATE OF KANSAS)
) SS
 COUNTY OF SEDGWICK)

I, D. L. Hellar, do hereby certify that the above and foregoing is a true and correct copy of the log of the #1 Frusher, located in c NE SW 9-21S-23W, Hodgeman, County, Kansas, as reflected by the files of the Hellar Drilling Company, Inc.

HELLAR DRILLING COMPANY, INC.

By *D. L. Hellar*
 President - D. L. Hellar

Subscribed and sworn to before me, a Notary Public, in and for Sedgwick County, Kansas, this 14th day of December, 1972.

My Commission Expires:

Catherine Darcey
 Notary Public - Catherine Darcey

March 25, 1976.