


STATE OF KANSAS  
STATE CORPORATION COMMISSION

WELL PLUGGING RECORD

Give All Information Completely  
Make Required Affidavit  
Mail or Deliver Report to  
Conservation Division  
State Corporation Comm.  
245 North Water  
Wichita, KS 67202

N/2 N/2 SE County. Sec. 22 Twp. 21 Rge. 21 E/W  
Location as "NE/CNW 1/4 SW 1/4" or footage from lines \_\_\_\_\_

Lease Owner Galloway Drilling Co., Inc.  
Lease Name Blount Well No. 5  
Office Address 105 So. Broadway, Wichita, KS 67202  
Character of Well (Completed as Oil, Gas or Dry Hole) \_\_\_\_\_  
Dry Hole.

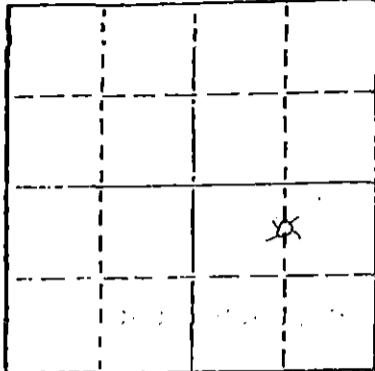

Date Well completed 4/9/82 19\_\_\_\_  
Application for plugging filed 4/9/82 19\_\_\_\_  
Application for plugging approved 4/9/82 19\_\_\_\_  
Plugging commenced 4/9/82 19\_\_\_\_  
Plugging completed 4/9/82 19\_\_\_\_  
Reason for abandonment of well or producing formation \_\_\_\_\_

D&A  
If a producing well is abandoned, date of last production \_\_\_\_\_ 19\_\_\_\_

Was permission obtained from the Conservation Division or its agents before plugging was commenced? yes

Name of Conservation Agent who supervised plugging of this well Steve Durrant  
Producing formation none Depth to top \_\_\_\_\_ Bottom \_\_\_\_\_ Total Depth of Well 4343'  
Show depth and thickness of all water, oil and gas formations.

OIL, GAS OR WATER RECORDS

CASING RECORD

FORMATION	CONTENT	FROM	TO	SIZE	PUT IN	PULLED OUT

Describe in detail the manner in which the well was plugged, indicating where the mud fluid was placed and the method or methods used in introducing it into the hold. If cement or other plugs were used, state the character of same and depth placed, from \_\_\_\_\_ feet to \_\_\_\_\_ feet for each plug set.

Ran 60 sacks 50/50 poz cement  
+3% CC + 4% Gel (60sks)  
Plug down 1:00 p.m.

(If additional description is necessary, use BACK of this sheet)

Name of Plugging Contractor Galloway Drilling Co., Inc.  
340 Broadway Plaza Bldg.  
105 So. Broadway, Wichita, KS 67202

STATE OF KANSAS COUNTY OF SEDGWICK ss:

Jay H. Galloway (employee of owner) or (owner or operator) of the above-described well, being first duly sworn on oath, says: That I have knowledge of the facts, statements, and matters herein contained and the log of the above-described well as filed and that the same are true and correct. So help me God.

**EARLENE M. LUMRY**  
STATE NOTARY PUBLIC  
SEDGWICK COUNTY, KANSAS  
MY APPT. EXP. \_\_\_\_\_

(Signature) Jay H. Galloway  
105 So. Broadway, Wichita, KS 67202  
16th day of April 19 82

My commission expires 9/7/85

Earlene M. Lumry Notary Public.

RECEIVED  
STATE CORPORATION COMMISSION

APR 19 1982

CONSERVATION DIVISION  
Wichita, Kansas

4-19-1982