


WELL PLUGGING RECORD

Give All Information Completely  
Make Required Affidavit  
Mail or Deliver Report to:  
Conservation Division  
State Corporation Commission  
212 North Market, Insurance Bldg.  
Wichita, Kansas

Stafford County. Sec. 2 Twp. 21 Rge. (E) 12 (W)

Location as "NE/CNW/SW" or footage from lines SW-NW - NW  
Lease Owner Meltzer Oil Company  
Lease Name Hewitt Well No. 3  
Office Address Great Bend, Kansas  
Character of Well (completed as Oil, Gas or Dry Hole)  
Date well completed 19  
Application for plugging filed 19  
Application for plugging approved 19  
Plugging commenced 4-9 1960  
Plugging completed 4-14 19 60  
Reason for abandonment of well or producing formation

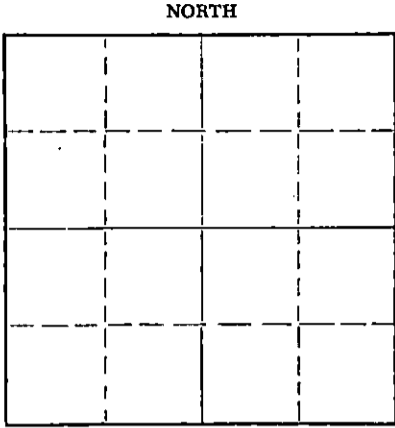

Locate well correctly on above Section Plat

If a producing well is abandoned, date of last production 19  
Was permission obtained from the Conservation Division or its agents before plugging was commenced? Yes

Name of Conservation Agent who supervised plugging of this well Frank Broadfoot  
Producing formation Depth to top Bottom Total Depth of Well Feet  
Show depth and thickness of all water, oil and gas formations.

OIL, GAS OR WATER RECORDS

CASING RECORD

FORMATION	CONTENT	FROM	TO	SIZE	PUT IN	PULLED OUT
				8 5/8	254	None
				5 1/2	3440	2975.64

Describe in detail the manner in which the well was plugged, indicating where the mud fluid was placed and the method or methods used in introducing it into the hole. If cement or other plugs were used, state the character of same and depth placed, from feet to feet for each plug set.

Filled with sand to 3430' - dumped 5 sacks of cement - bailed off fluid to 240' - filled with mud to 240' - set 10' rock bridge - dumped 15 sacks of cement - mudded to 40' - set rock bridge and dumped 10 sacks of cement on top.

RECEIVED  
STATE CORPORATION COMMISSION

APR 27 1960

CONSERVATION DIVISION  
Wichita, Kansas

(If additional description is necessary, use BACK of this sheet)  
Name of Plugging Contractor R & D Casing Pulling Company License # 236  
Address Box 154 Ellinwood, Kansas

STATE OF Kansas, COUNTY OF Barton, ss.  
Nathan Meltzer (employee of owner) or (owner or operator) of the above-described well, being first duly sworn on oath, says: That I have knowledge of the facts, statements, and matters herein contained and the log of the above-described well as filed and that the same are true and correct. So help me God.

(Signature) *Nathan Meltzer*  
Box 191, Great Bend, Kansas  
(Address)

SUBSCRIBED AND SWORN TO before me this 25th day of April, 1960

My commission expires 3/30/61

*Anne Meltzer*  
Anne Meltzer Notary Public.



15.185.12997.0000

DRILLER'S LOG

COMPANY: THE LOTUS OIL COMPANY

LOCATION: SW NW NW 2-21-12  
Stafford County, Kansas

CONTRACTOR: HILTON DRILLING COMPANY, INC.

ELEVATION: 1847 DF

FARM NAME: HEWITT NO. 3

COMMENCED: 12-16-51

COMPLETED: 12-27-51

CASING USED: 8-5/8" at 254' with 250 sacks  
5-1/2" at 3440' with 75 sacks

Sand	41
Sand, Gravel	240
Red Bed	254
Red Bed, Shells	600
Red Bed	610
Anhydrite	640
Shale and Shells	1430
Broken Lime	1695
Lime	1835
Lime Broken	1940
Lime and Shale	2765
Lime	3115
Lime and Shale	3170
Lime	3441
Total Depth	3441

RECEIVED  
STATE CORPORATION COMMISSION

APR 4 1960

CONSERVATION DIVISION  
Wichita, Kansas

STATE OF KANSAS )  
                          ) SS  
COUNTY OF BARTON )

I, the undersigned, being duly sworn on oath, state that the above statement and log are true and a correct record and log of the well drilled at the location above described.

HILTON DRILLING COMPANY, INC.

*Terry Pearson*  
Secretary

Subscribed and sworn to before me this 31st day of December, 1951.

*Edwina Elder*  
Notary Public

My commission expires September 21, 1953.