


STATE OF KANSAS
STATE CORPORATION COMMISSION

Give All Information Completely
Make Required Affidavit
Mail or Deliver Report to:
Conservation Division
State Corporation Commission
212 No. Market
Wichita, Kansas 67202

WELL PLUGGING RECORD

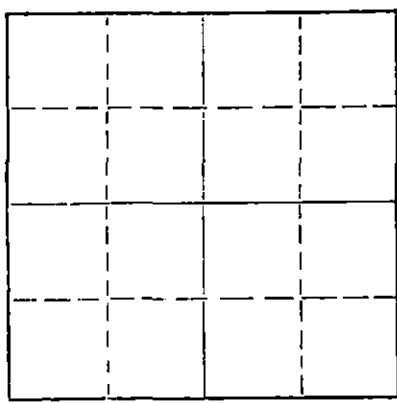

Locate well correctly on above
Section Plat

Stafford County, Sec. 2 Twp. 21S Rge. (E) 12 (W)
Location as "NE/CNW/SW" or footage from lines SE SE SW
Lease Owner Beacon Resources Corp.
Lease Name Rujan Well No. 1
Office Address 1000 Century Plaza - Wichita, Kansas
Character of Well (completed as Oil, Gas or Dry Hole) dry
Date well completed 12-11-70 19 70
Application for plugging filed 12-11 19 70
Application for plugging approved 12-11 19 70
Plugging commenced 7:30 PM 12-11 19 70
Plugging completed 8:00 PM 12-11 19 70
Reason for abandonment of well or producing formation dry

If a producing well is abandoned, date of last production 19
Was permission obtained from the Conservation Division or its agents before plugging was commenced? yes

Name of Conservation Agent who supervised plugging of this well Ralph Warren - Pratt, Kansas
Producing formation _____ Depth to top _____ Bottom _____ Total Depth of Well 3485 Feet
Show depth and thickness of all water, oil and gas formations.

OIL, GAS OR WATER RECORDS

CASING RECORD

FORMATION	CONTENT	FROM	TO	SIZE	PUT IN	PULLED OUT
sand clay red rock		0	331	8 5/8	329	0

Describe in detail the manner in which the well was plugged, indicating where the mud fluid was placed and the method or methods used in introducing it into the hole. If cement or other plugs were used, state the character of same and depth placed, from _____ feet to _____ feet for each plug set.

Plug set @ 325' w/25 sx cement
Plug set @ 40' w/10 sx cement
2 sx in rat hole

RECEIVED
STATE CORPORATION COMMISSION
DEC 17 1970
CONSERVATION DIVISION
Wichita, Kansas

(If additional description is necessary, use BACK of this sheet)
Name of Plugging Contractor B & B Drilling, Inc.
Address 720 Union Center - Wichita, Kansas 67202

STATE OF Kansas, COUNTY OF Sedgwick, ss.
Bill Lahar (employee of owner) or (owner or operator) of the above-described

well, being first duly sworn on oath, says: That I have knowledge of the facts, statements, and matters herein contained and the log of the above-described well as filed and that the same are true and correct. So help me God.

(Signature) Bill Lahar
720 Union Center - Wichita, Kansas
(Address)

SUBSCRIBED AND SWORN TO before me this 16th day of December, 1970

My commission expires May 31, 1974
Alma A. Neises Notary Public.

B & B DRILLING, INC.207 Petroleum Building
Wichita, Kansas 67202

December 16, 1970

RECEIVED
STATE CORPORATION COMMISSION

DEC 17 1970

CONSERVATION DIVISION
Wichita, KansasDRILLERS LOGRe: Rugan #1
SE SE SW Section 2-21S-12W
Stafford County, KansasOPERATOR: Beacon Resources Corp.
CONTRACTOR: B & B Drilling, Inc.
COMMENCED: December 4, 1970
COMPLETED: December 12, 1970
TOTAL DEPTH: 3485'

Ran 8 5/8" @ 329' w/275 sx

0	190	Sand
190	331	Clay & Red Rock $\frac{1}{2}$
331	1268	Red Bed w/ Shale
1268	1400	Shale
1400	1610	Lime & Shale
1610	1820	Lime & Shale
1820	2000	Lime w/Shale
2000	2305	Shale & Shells
2305	2530	Shale & Shells
2530	2600	Lime & Shale
2600	2775	Lime w/Shale
2775	2945	Lime & Shale
2945	3030	Lime & Shale
3030	3190	Lime
3190	3340	Lime
3340	3415	Lime
3415	3444	Lime
3444	3485	Lime
3485		Total Depth

DST #1	3232 - 3267'
DST #2	3262 - 3293'
DST #3	3340 - 3355'
DST #4	3360 - 3384'

We certify the above and foregoing to be true
and correct copy of the log on the #1 Rugan, located
in Stafford County, Kansas.Bill Lohar

President

Alma C. Neises

Notary Public

Subscribed and sworn to before me this 16th
day of December, 1970. My commission expires
May 31, 1974