

15.185.11559.0000

STATE OF KANSAS
STATE CORPORATION COMMISSION

WELL PLUGGING RECORD

Give All Information Completely
Make Required Affidavit
Mail or Deliver Report to:
Conservation Division
State Corporation Commission
800 Bittling Building
Wichita, Kansas

Stafford

County, Sec. 2 Twp. 21 Rge. 12 (W)

Location as "NE/CNW/SW" or footage from lines NE/4 NE/4 NW/4

Lease Owner The Lotus Oil Company

Lease Name Hewitt Well No. 4

Office Address 900 Riss Building, Kansas City, Mo.

Character of Well (completed as Oil, Gas or Dry Hole) Dry hole

Date well completed March 2 19 54

Application for plugging filed March 2nd 19 54

Application for plugging approved March 2nd 19 54


Plugging commenced March 2nd 19 54

Plugging completed March 3rd 19 54

Reason for abandonment of well or producing formation dry hole

If a producing well is abandoned, date of last production 19

Was permission obtained from the Conservation Division or its agents before plugging was commenced? yes

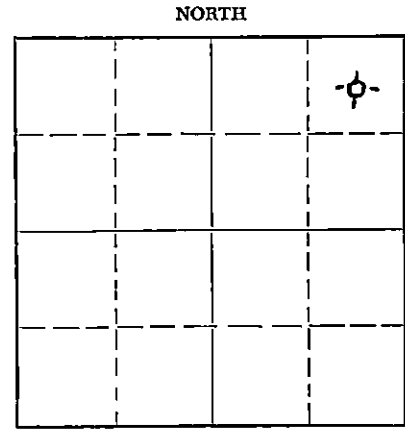

Locate well correctly on above Section Plat

Name of Conservation Agent who supervised plugging of this well M. A. Rives

Producing formation Depth to top Bottom Total Depth of Well 3430 Feet

Show depth and thickness of all water, oil and gas formations.

OIL, GAS OR WATER RECORDS

CASING RECORD

FORMATION	CONTENT	FROM	TO	SIZE	PUT IN	PULLED OUT
		0	248	8-5/8"	248'	none

Describe in detail the manner in which the well was plugged, indicating where the mud fluid was placed and the method or methods used in introducing it into the hole. If cement or other plugs were used, state the character of same and depth placed, from feet to feet for each plug set.

Hole filled with heavy rotary mud from total depth to 240'; plug set at 240' with 20 sacks cement and 1/2 sack hulls - top plug set at 35' - hole filled to surface with 10 sacks cement

(If additional description is necessary, use BACK of this sheet)

Name of Plugging Contractor Hilton Drilling Company, Inc.
Address 2421 10th Street, Great Bend, Kansas

STATE OF Kansas, COUNTY OF Barton, ss.
Henry Peacock, Secretary (employee of owner) or (owner or operator) of the above-described

well, being first duly sworn on oath, says: That I have knowledge of the facts, statements, and matters herein contained and the log of the above-described well as filed and that the same are true and correct. So help me God.

(Signature) *Henry Peacock*
2421 10th Street, Great Bend, Kansas
(Address)

SUBSCRIBED AND SWORN to before me this 3rd day of March, 19 54

Margaret Whitman
Notary Public.

My commission expires 4-4-56

24-7988-5 3-53-20M

PLUGGING
FILE SEC 2 T 21 R 12 W
PAGE 18 LINE 3

3-9-54

DRILLER'S LOG

Company: The Lotus Oil Company Location: NE NE NW
 Contractor: Hilton Drilling Company, Inc. Sec. 2-21-12W
 Farm name: Hewitt No. 4. Stafford County,
 Kansas
 Commenced: 2-22-54 Elevation: 1828 DF
 Completed: 3-3-54 Casing used: 8-5/8"@ 248' w/300 sks.

Sand	70
Sand and clay streaks	210
Shale	305
RedBed	590
Anhydrite	615
Red Bed and shale	715
Shale and Red Rock	900
Shale and shells	1095
Shale and salt	1300
Shale and shells	1500
Lime and shale	1555
Broken lime and sand	1720
Broken lime	1820
Florence flint	1843
Shale and lime	1868
Lime	1925
Lime and shale	2045
Lime	2190
Broken lime and shale	2260
Shale and shells	2310
Lime and shale	2805
Lime	3016
Heebner shale	3020
Shale and lime	3177
Lime	3367
Lime, shale, chert	3390
Conglomerate	3396
Simpson Sand and shale	3430
TOTAL DEPTH	3430.

STATE OF KANSAS)
) ss.
 COUNTY OF BARTON)

RECEIVED
 STATE CORPORATION COMMISSION
 MAR 6 - 1954
 CONSERVATION DIVISION
 Wichita, Kansas

I,, the undersigned, being duly sworn on oath, state that the above statement and log are true and a correct record and log of the well drilled at the location above described.

Henry Peacock
 Henry Peacock, Secretary

Subscribed and sworn to before me this 7th day of March, 1954.

PLUGGING
 FILE REC 2 T 21 R 12W
 BOOK PAGE 18 LINE 3

Margaret Whitman
 Notary Public

My commission expires 4-4-56