


WELL PLUGGING RECORD

Give All Information Completely
Make Required Affidavit
Mail or Deliver Report to:
Conservation Division
State Corporation Commission
800 Bittling Building
Wichita, Kansas

NORTH

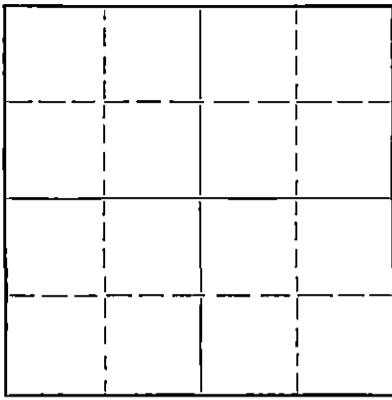

Locate well correctly on above
Section Plat

Stafford County. Sec. 2 Twp. 21 Rge. (E) 12 (W)
Location as "NE/CNW $\frac{1}{4}$ SW $\frac{1}{4}$ " or footage from lines NW NW SW $\frac{1}{4}$
Lease Owner Armer Drilling Co., Inc.
Lease Name Anderson Well No. /
Office Address 710 Petroleum Bldg. Wichita, Kansas
Character of Well (completed as Oil, Gas or Dry Hole) Oil well
Date well completed March 1951
Application for plugging filed Nov. 9 1951
Application for plugging approved Nov. 9 1951
Plugging commenced Nov. 10 1951
Plugging completed Nov. 13 1951
Reason for abandonment of well or producing formation Well depleted

If a producing well is abandoned, date of last production October 1951
Was permission obtained from the Conservation Division or its agents before plugging was commenced? Yes

Name of Conservation Agent who supervised plugging of this well C. D. Stough
Producing formation Arbuckle Depth to top 3460 Bottom 3466 Total Depth of Well 3467.64 Feet
Show depth and thickness of all water, oil and gas formations.

OIL, GAS OR WATER RECORDS

CASING RECORD

Formation	Content	From	To	Size	Put In	Pulled Out
				8-5/8	220	None
				5-1/2	3460	2617

Describe in detail the manner in which the well was plugged, indicating where the mud fluid was placed and the method or methods used in introducing it into the hole. If cement or other plugs were used, state the character of same and depth placed, from _____ feet to _____ feet for each plug set.

Filled back with crushed rock to 3450 ft., dumped 5 sacks cement at 3450 ft., top of cement 3415 ft., Filled hole with mud to 220 ft., set rock bridge. Dumped 15 sacks of cement, top of cement 175 ft. Filled with mud to 35 ft., set rock bridge, dumped 10 sacks of cement for cap.

(If additional description is necessary, use BACK of this sheet)

Name of Plugging Contractor Miller Casing Pulling Company
Address Great Bend, Kansas


STATE OF Kansas, COUNTY OF Sedgwick, ss.
L. C. Sponenberg (employee of owner) or (owner or operator) of the above-described well, being first duly sworn on oath, says: That I have knowledge of the facts, statements, and matters herein contained and the log of the above-described well as filed and that the same are true and correct. So help me God.

(Signature) L. C. Sponenberg
710 Petroleum Bldg. Wichita, Kan.
(Address)

SUBSCRIBED AND SWORN to before me this 19-th day of December, 1951

(Signature) Hazel Walter
Notary Public.

Commission expires September 17, 1955

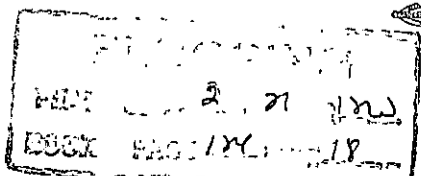

15.185.00456.0000

LOG

Company: Armer Drilling Company, Inc.
Contractor: Armer Drilling Company
Drilling commenced: 3/8/51
Drilling completed: 3/23/51
Elevation: 1857 D.F. 1853 Cr.
1859 R.B.
(Easco rig)

Farm: W. W. Anderson - well #1
Location: C NW NW SW of Sec.
2-21S-12W
Stafford County, Kansas
Casing record: 8 5/8 @ 220 ft.
W/150 sack cement
5 1/2 @ 3460 - 100 sacks.

(figures below indicate bottoms)

Sand & shale	215
Hard shale	220
Shale & shell	628
Anhydrite	650
Shale & shells	1040
Shale, shells & lime	1110
Shale & shell	1510
Lime	1680
Shale & lime	2370
Shale & shells	2500
Shale & lime	2760
Lime	3090
Shale & lime	2825
Lime	3430
Shale	3455
Shale & lime	3466
R. T. D.	3466

FORMATION TOPS:

Hoebner	3062
Kansas City	3206
Simpson	3420
Artuckle	3460

I hereby certify that this is a true and correct log of the above described well as shown by the drilling reports.

ARMER DRILLING COMPANY, INC.

By *L. L. Spradling*

STATE OF KANSAS }
COUNTY OF SEDGWICK }

SS: DEC 26, 1951

Subscribed and sworn to before me, a notary public, in and for said County and State this 27th day of March, 1951.

Harold Tractor
Notary Public

My commission expires Sept. 17, 1951.

FILED
MAR 27 1951
RICK PAGE