

STATE OF KANSAS
STATE CORPORATION COMMISSION


Form CP-4

Give All Information Completely
Make Required Affidavit
Mail or Deliver Report to:
Conservation Division
State Corporation Commission
212 No. Market
Wichita, Kansas 67202

WELL PLUGGING RECORD

Stafford County. Sec. 2 Twp. 21S Rge. 12W (E) (W) X

Location as "NE/CNWxSWx" or footage from lines NW SW SE
Lease Owner L.V. Stan Bell
Lease Name Salem Well No. 3
Office Address Suite 925, 200 W. Douglas, Wichita, Kansas
Character of Well (completed as Oil, Gas or Dry Hole) D & A
Date well completed April 17, 1971
Application for plugging filed April 17 19 71
Application for plugging approved April 17 19 71
Plugging commenced April 17 19 71
Plugging completed April 17 19 71
Reason for abandonment of well or producing formation D & A

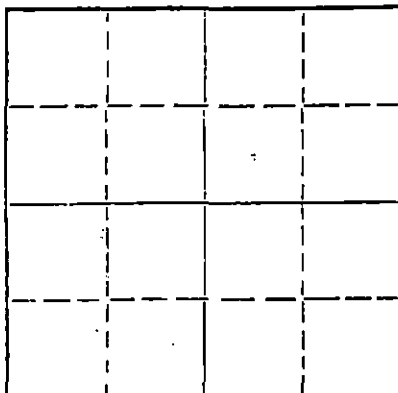

Locate well correctly on above
Section Plat

If a producing well is abandoned, date of last production 19
Was permission obtained from the Conservation Division or its agents before plugging was commenced? yes

Name of Conservation Agent who supervised plugging of this well Archie V. Elving
Producing formation Depth to top Bottom Total Depth of Well 3500 Feet
Show depth and thickness of all water, oil and gas formations.

OIL, GAS OR WATER RECORDS

CASING RECORD

FORMATION	CONTENT	FROM	TO	SIZE	PUT IN	PULLED OUT
				8 5/8"	231'	0

Describe in detail the manner in which the well was plugged, indicating where the mud fluid was placed and the method or methods used in introducing it into the hole. If cement or other plugs were used, state the character of same and depth placed, from feet to feet for each plug set.

Spot 40 sx 50/50 Posmix w/6% gel
@ 500'. spot 25 sx @ 200', mud to
40' 1/2 sx hulls, plug, cement to
base of cellar. 2 sx in rathole

RECEIVED
STATE CORPORATION COMMISSION
JAN 8 1974
CONSERVATION DIVISION
Wichita, Kansas

(If additional description is necessary, use BACK of this sheet)

Name of Plugging Contractor Red Tiger Drilling Co.
Address 1720 Wichita Plaza, Wichita, Kansas

STATE OF Kansas, COUNTY OF Sedgwick, ss.
Jim Farrice (employee of owner) or (owner or operator) of the above-described

well, being first duly sworn on oath, says: That I have knowledge of the facts, statements, and matters herein contained and the log of the above-described well as filed and that the same are true and correct. So help me God.

(Signature) Jim Farrice
1720 Wichita Plaza, Wichita, Kansas
(Address)

Subscribed and sworn to before me this 19th day of April, 1971



Virginia H. Albert
Notary Public.

My commission expires July 23, 1974

DRILLERS LOG

No. 3 Salem

CASING RECORD:	COMPANY:	L. V. Stan Bell	DESCRIPTION:
8 5/8" @231'	CONTRACTOR:	Red Tiger Drilling Co.	NW SW SE
w/225 sx cement	COMMENCED:	April 9, 1971	2-21S-12W
	COMPLETED:	April 17, 1971	Stafford County, Kansas
TOTAL DEPTH: 3500'			ELEVATION:

<u>FORMATION</u>	<u>FROM</u>	<u>TO</u>	<u>REMARKS</u>
Sand	0	190	
Shale & Red Bed	190	230	
Red Bed	230	613	
Anhydrite	613	629	
Shale	629	1405	
Lime	1405	1430	
Lime & Shale	1430	2935	
Lime	2935	3051	
Heebner	3051	3056	
Lime	3056	3082	
Douglas	3082	3187	
Lime	3187	3474	
Arbuckle	3474	3500	


RECEIVED
STATE CORPORATION COMMISSION
JAN 8 1974
CONSERVATION DIVISION
Wichita, Kansas

I certify that this is a true and correct copy of the above log to the best of my knowledge.

RED TIGER DRILLING COMPANY

Jim Farrice
Jim Farrice

Subscribed and sworn to before me this 19th day of April, 1971.

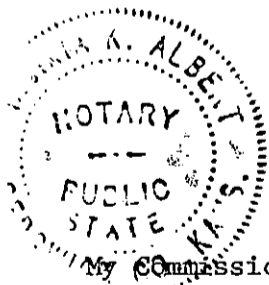

Virginia K. Albert
Notary Public

My Commission Expires:

July 23, 1974