


WELL PLUGGING RECORD

Give All Information Completely
Make Required Affidavit
Mail or Deliver Report to:
Conservation Division
State Corporation Commission
212 North Market, Insurance Bldg.
Wichita, Kansas

NORTH

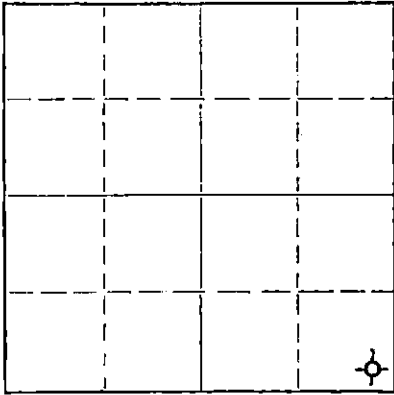

Locate well correctly on above
Section Plat

Stafford County. Sec. 2 Twp. 21S Rge. 12 (E) W (W)
Location as "NE/CNWSW" or footage from lines SE SE SE
Lease Owner C-G Drilling Co. & R. W. Shields
Lease Name Robl Well No. 1
Office Address 107 Rule Building, Wichita 2, Kansas
Character of Well (completed as Oil, Gas or Dry Hole) Dry hole
Date well completed August 1 1961
Application for plugging filed August 1 1961
Application for plugging approved August 1 1961
Plugging commenced August 1 1961
Plugging completed August 1 1961
Reason for abandonment of well or producing formation Too low structurally

If a producing well is abandoned, date of last production _____ 19____
Was permission obtained from the Conservation Division or its agents before plugging was commenced? Yes

Name of Conservation Agent who supervised plugging of this well Eldon Petty, Hays, Kansas
Producing formation _____ Depth to top _____ Bottom _____ Total Depth of Well 3529 Feet
Show depth and thickness of all water, oil and gas formations.

OIL, GAS OR WATER RECORDS

CASING RECORD

FORMATION	CONTENT	FROM	TO	SIZE	PUT IN	PULLED OUT
				8-5/8"	299.72'	None

Describe in detail the manner in which the well was plugged, indicating where the mud fluid was placed and the method or methods used in introducing it into the hole. If cement or other plugs were used, state the character of same and depth placed, from _____ feet to _____ feet for each plug set.

Filled hole with heavy mud to 240'. Set plug. Put in 20 sacks cement and 1/2 sack hulls. Filled with heavy mud up to 35'. Set plug. Filled to top with 1/2 sack hulls and 10 sacks cement.

RECEIVED
STATE CORPORATION COMMISSION

AUG 7

CONSERVATION DIVISION
Wichita, Kansas

8-7-61

(If additional description is necessary, use BACK of this sheet)
Name of Plugging Contractor C-G Drilling Co.
Address 107 Rule Building, Wichita 2, Kansas


STATE OF KANSAS, COUNTY OF SEDGWICK, ss.
G. F. Galloway (employee of owner) or (owner or operator) of the above-described well, being first duly sworn on oath, says: That I have knowledge of the facts, statements, and matters herein contained and the log of the above-described well as filed and that the same are true and correct. So help me God.

(Signature) G. F. Galloway
107 Rule Building
(Address)

Subscribed and sworn to before me this 4th day of August, 1961

My commission expires May 20, 1963

Vicky Jacobs
Notary Public.

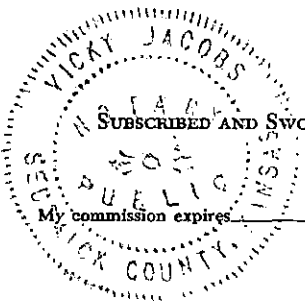

W E L L L O G

OPERATOR C-G Drilling Co. & R. W. Shields SEC. 2-21S-12W
 WELL NAME Robl #1 LOC. SE SE SE
 TOTAL DEPTH 3529' COUNTY Stafford
 COMM. July 23, 1961 COMP. August 1, 1961 STATE Kansas
 RIG NO. 2 ELEVATION 1831' K.B.
 CASING: Ran 299.72' (10 jts.) 8-5/8" OD Surface Casing. PRODUCTION: D & A

All measurements taken from the top of rotary bushing.

FROM	TO	FORMATION	DEVIATION FROM VERTICAL	REMARKS:
0	210	Sand		
210	596	Red Bed		
596	626	Anhydrite		
626	920	Shale & Shell		
920	1425	Shale & Shells		
1425	2700	Lime & Shale	00 - 2500	
2700	2830	Lime	00 - 2750	
2830	3055	Lime & Shale	00 - 3000	
3055	3529	Lime	00 - 3250 00 - 3500	

RECEIVED
 STATE CORPORATION COMMISSION
 AUG 7 1961
 CONSERVATION DIVISION
 Wichita, Kansas

STATE OF KANSAS)
 COUNTY OF SEDGWICK) SS.

The undersigned hereby certifies that to the best of his knowledge and belief, the above facts are true and correct.

C-G DRILLING CO.

By G. F. Galloway
 G. F. Galloway

THIS 4th day of August, 1961.

Vicky Jacobs
 Vicky Jacobs - Notary Public

