

WELL PLUGGING RECORD

STATE OF KANSAS STATE CORPORATION COMMISSION

FORMATION PLUGGING RECORD

Give All Information Completely Make Required Affidavit Mail or Deliver Report to: Conservation Division State Corporation Commission 300 Bitting Building Wichita, Kansas

OR

Strike out upper line when reporting plugging of formations.

Stafford County. Sec. 2 Twp. 21 Rge. 11 (E) 11 (W)

Location as "NE 1/4 NW 1/4 SW 1/4" or footage from lines NE 1/4 NE 1/4 NE 1/4

Lease Owner Edw. H. Isern, etaal

Lease Name Copeland Well No. 1

Office Address Box 92, Ellinwood, Kansas

Character of Well (completed as Oil, Gas or Dry Hole) Dry Hole

Date well completed 3-31 1950

Application for plugging filed 3-31 1950

Application for plugging approved 3-31 1950


Plugging commenced 3-31 1950

Plugging completed 3-31 1950

Reason for abandonment of well or producing formation Dry Hole

If a producing well is abandoned, date of last production None 19

Was permission obtained from the Conservation Division or its agents before plugging was commenced? Yes

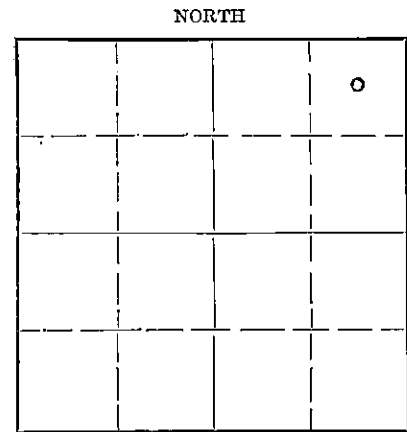

Locate well correctly on above Section Plat

Name of Conservation Agent who supervised plugging of this well C. D. Stough

Producing formation Depth to top Bottom Total Depth of Well 3411 Feet

Show depth and thickness of all water, oil and gas formations.

OIL, GAS OR WATER RECORDS

CASING RECORD

Table with 7 columns: Formation, Content, From, To, Size, Put In, Pulled Out. Row 1: Surface Pipe, 0, 245', 8 5/8", 245', None.

Describe in detail the manner in which the well was plugged, indicating where the mud fluid was placed and the method or methods used in introducing it into the hole. If cement or other plugs were used, state the character of same and depth placed, from feet to feet for each plug set.

Mudded hole with heavy mud to 245'. Bridged hole with rock at 245'. Mudded with heavy Mud and bridged at 40'. Cemented with 10 sacks cement returning to base of cellar.

RECEIVED

APR 18 1950 4-18-50

STATE OF KANSAS

(If additional description is necessary, use BACK of this sheet)

Correspondence regarding this well should be addressed to G. W. Keyes Drilling Co. Ellinwood, Kansas

STATE OF Kansas COUNTY OF Barton ss.

I, Edw. H. Isern, Part Owner (employee of owner) or (owner or operator) of the above-described well, being first duly sworn on oath, says: That I have knowledge of the facts, statements, and matters herein contained and the log of the above-described well as filed and that the same are true and correct. So help me God.

(Signature) Edw. H. Isern

Ellinwood, Kansas (Address)

SUBSCRIBED AND SWORN to before me this 17th day of April, 1950

George Meyer Notary Public.

My commission expires February 10, 1951.

PLUGGING FILE SEC 2 T 21 R 11W BOOK PAGE 146 LINE 2

WELL LOG

Edw. H. Isern et al, Owners - Copeland #1  
NE 1/4 NE 1/4 NE 1/4 Section 2, Township 21S, Range 11W  
Stafford County, Kansas

Elevation: 1765 DF

Pipe Record:

8 5/8" set at 245'

Tops Rotary Bushing Measurement

Topeka 2675  
Heebner 2912  
Brown Lime 3041  
Lansing 3068  
Conglomerate 3315  
Arbuckle 3371

Rotary commenced 3-23-50  
completed 3-31-50

Figures indicate bottom of formation  
0 to 130 sand and clay  
245 shale and shells  
453 red bed and shale  
480 anhydrite  
965 shale and shells  
1170 salt  
1320 shale and shells  
1670 shale and lime  
1690 sand  
2090 shale and lime  
2300 shale and shells  
2440 shale and lime  
2530 shale and shells  
2750 shale and lime  
2913 lime and shale  
2917 Heebner shale  
3315 lime and shale  
3345 conglomerate and chert  
3371 conglomerate  
3411 arbuckle lime  
3411 Total Depth D & A

STATE OF KANSAS )  
COUNTY OF BARTON ) SS

I, Edw. H. Isern, Part Owner, of the above-described well, being first duly sworn on oath, declare: That I have knowledge of the facts, statements and matters herein contained pertaining to the log of the above-described well, as filed, and that the same are true and correct.

*Edw. H. Isern*

Subscribed and Sworn to before me this 17th day of April, 1950.

*George A. Meyer*  
Notary Public

My commission expires Feb. 10, 1951.

RECEIVED

Conservation Dept.

APR 18 1950

STATE CORPORATION  
COMMISSION  
KANSAS

PLUGGING  
FILE SEC-2-T-21R-114  
BOOK PAGE 19 LINE 2