

STATE OF KANSAS
STATE CORPORATION COMMISSION

WELL PLUGGING RECORD


Give All Information Completely
Make Required Affidavit
Mail or Deliver Report to:
Conservation Division
State Corporation Commission
800 Bittling Building
Wichita, Kansas

FORMATION PLUGGING RECORD

Strike out upper line when reporting plugging off formations.

Stafford County. Sec. 2 Twp. 21 S Rge. 11 (W)

Location as "NE 1/4 NW 1/4 SW 1/4" or footage from lines NE SW NE
Lease Owner F. G. Holl
Lease Name Rugan D Well No. 3
Office Address 6127 East Kellogg
Character of Well (completed as Oil, Gas or Dry Hole) oil
Date well completed August 13 19 64
Application for plugging filed Sept. 3 19 65
Application for plugging approved Sept. 7 19 65
Plugging commenced Sept. 3 19 65
Plugging completed Sept. 4 19 65
Reason for abandonment of well or producing formation depleted
If a producing well is abandoned, date of last production January 19 65
Was permission obtained from the Conservation Division or its agents before plugging was commenced? yes

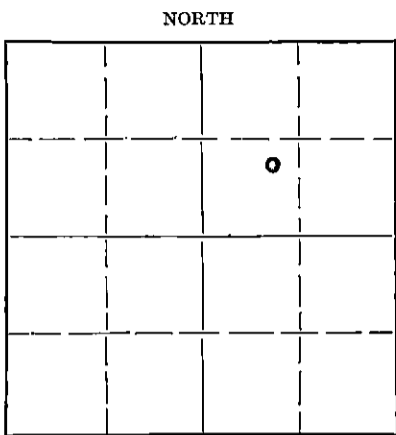

Locate well correctly on above Section Plat

Name of Conservation Agent who supervised plugging of this well Archie Elving
Producing formation Arbuckle Depth to top 3375 Bottom 3386 Total Depth of Well 3386 Feet
Show depth and thickness of all water, oil and gas formations.

OIL, GAS OR WATER RECORDS

CASING RECORD

| Formation | Content | From | To | Size | Put In | Pulled Out |
|-----------------|------------|-------------|-------------|--------|--------|------------|
| | | | | 8 5/8" | 274 | |
| <u>Arbuckle</u> | <u>oil</u> | <u>3375</u> | <u>3386</u> | | | |
| | | | | 4 1/2" | 3377 | 2740 |

Describe in detail the manner in which the well was plugged, indicating where the mud fluid was placed and the method or methods used in introducing it into the hole. If cement or other plugs were used, state the character of same and depth placed, from 3386 feet to 3360 feet for each plug set.

Total Depth: 3386'
Sand to 3360. 3 sacks cement on top.

Pulled 2740' 4 1/2"

Filled hole with mud to 200'. Set Halliburton plug - rock bridge with 25 sacks cement on top.

Mud to 40' - Halliburton plug. 10 sacks cement on top.

Plugging contractor: Manning Drilling Co. # 386

RECEIVED
STATE CORPORATION COMMISSION

SEP 10 1965

CONSERVATION DIVISION
Wichita, Kansas

(If additional description is necessary, use BACK of this sheet)

Correspondence regarding this well should be addressed to F. G. Holl
Address 6127 East Kellogg Wichita 7, Kansas

STATE OF KANSAS, COUNTY OF SEDGWICK, ss.
F. G. Holl (employee of owner) or (owner or operator) of the above-described well, being first duly sworn on oath, says: That I have knowledge of the facts, statements, and matters herein contained and the log of the above-described well as filed and that the same are true and correct. So help me God.

(Signature) [Signature]
6127 East Kellogg Wichita 7, Kansas
(Address)

SUBSCRIBED AND SWORN to before me this 9th day of September, 19 65

My commission expires August 5, 1969
Mary E. Lacey Notary Public.

W E L L L O G

Date Commenced: July 2, 1964
Date Completed: July 10, 1964

F. G. Holl
RUGAN D-3
NE SW NE Sec. 2-21-11W
Stafford County, Kansas

ELEVATION: 1767 K.B.

- 0 - 150' Sand & Clay
- 150 - 462' Red Bed
- 462 - 488' Anhydrite
- 488 - 1000' Red Bed-Shells-Shale
- 1000 - 1653' Salt-Shale-Shells
- 1653 - 2025' Lime & Shale
- 2025 - 2670' Lime & Shale
- 2670 - 2921' Lime
- 2921 - 2926' Shale
- 2926 - 2954' Lime & Shale
- 2954 - 3051' Shale
- 3051 - 3071' Brown Lime
- 3071 - 3301' Lime
- 3301 - 3323' Lime & Shale
- 3323 - 3349' Conglomerate
- 3349 - 3379' Shale
- 3379 - 3382' Dolomite

SURFACE CASING: Set 8 5/8" casing at 274' with 225 sacks cement.

PRODUCTION CASING: Set 4 1/2 casing 3380' with 75 sacks salt cement.

RECEIVED
STATE CORPORATION COMMISSION
SEP 7 1965
CONSERVATION DIVISION
Wichita, Kansas

A F F I D A V I T

STATE OF KANSAS
COUNTY OF BARTON) ss.

L. O. Chubb, of lawful age, does swear that the facts and statements herein contained are true and correct to the best of his knowledge.

L. O. Chubb

Subscribed and sworn to before me this 15 day of July, 1964.

My Commission Expires:
June 24, 1967

Clair E. Stimson
Clair E. Stimson-Notary Public