

STATE OF KANSAS
STATE CORPORATIONS COMMISSION


WELL PLUGGING RECORD

Give All Information Completely
Make Required Affidavit
Mail or Deliver Report to:
Conservation Division
State Corporation Commission
800 Bitting Building
Wichita, Kansas

OR
FORMATION PLUGGING RECORD

Strike out upper line when reporting plugging of formations.

NORTH

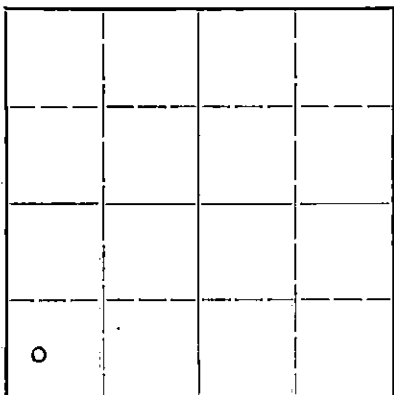

Locate well correctly on above Section Plat

Stafford County. Sec. 34 Twp. 21 Rge. 12 (E) W (W)
Location as "NE $\frac{1}{4}$ NW $\frac{1}{4}$ SW $\frac{1}{4}$ " or footage from lines. SW $\frac{1}{2}$ SW $\frac{1}{2}$ SW $\frac{1}{2}$
Lease Owner. Fred P. Rust, et al,
Lease Name. Wittrock #1 Well No. I
Office Address. c/o C-G Drlg. Co., Wichita, Kansas
Character of Well (completed as Oil, Gas or Dry Hole). Dry Hole
Date well completed. June 22, 1948
Application for plugging filed. June 22, 1948
Application for plugging approved. June 22, 1948
Plugging commenced. June 23, 1948
Plugging completed. June 23, 1948
Reason for abandonment of well or producing formation. No oil in Known producing formations. Structurally low.
If a producing well is abandoned, date of last production. -- 19--
Was permission obtained from the Conservation Division or its agents before plugging was commenced? Yes

Name of Conservation Agent who supervised plugging of this well. Stough, Great Bend
Producing formation. -- Depth to top. -- Bottom. -- Total Depth of Well. 3692 Feet
Show depth and thickness of all water, oil and gas formations.

OIL, GAS OR WATER RECORDS

CASING RECORD

Formation	Content	From	To	Size	Put In	Pulled Out
				8-5/8"	229.39	none

Describe in detail the manner in which the well was plugged, indicating where the mud fluid was placed and the method or methods used in introducing it into the hold. If cement or other plugs were used, state the character of same and depth placed, from _____ feet to _____ feet for each plug set.

Filled with Drilling Mud to 232'. Drove plug to 230'. Put in 15 sacks cement then pumped full of mud 25' from top of hole. Drove plug down 25' then filled to top with 10 sacks of cement.

6-25-1948

JUN 25 1948

(If additional description is necessary, use BACK of this sheet)

Correspondence regarding this well should be addressed to. C-G Drilling Company
Address. 206 Union Natl Bank Bldg., Wichita, Kansas

STATE OF Kansas, COUNTY OF Sedgwick, ss.

R. A. Cook (employee of owner) or (owner or operator) of the above-described well, being first duly sworn on oath, says: That I have knowledge of the facts, statements, and matters herein contained and the log of the above-described well as filed and that the same are true and correct. So help me God.

C-G DRILLING CO., Inc.
(Signature) By [Signature] President

SUBSCRIBED AND SWORN to before me this 23rd day of June, 1948

My commission expires June 25, 1951

[Signature]
Notary Public.

PLUGGING
FILE NO. 34-21-12W
BOOK 140-117

CONTRACTOR'S WELL LOG

Operator G-G Drilling Company Well Name Wittrock No. I
 Location SW, Sec 32, Twp. 21 S, Rge. 12 W.
 Well Name Sittner County Stafford State Kansas
 Commencement Date June 11, 1948 Completion Date June 25, 1948

LOG NO. 221

Elevation 1287'


All measurements from the top of rotary busting.

DEPTH	TO	FORMATION	DEVIATION	REMARKS
			VERTICAL	
0	230			
230	644	Red bed-Shale		
644	668	Anhydrite		
668	1198	Shale-Shells	1100' - 0°	
1198	1810	Shale-Shells		
1810	1850	Shale-Lime	1800' - 0°	
1850	1780	Shale-Lime		
1780	1900	Lime		
1900	2035	Lime		
2035	2158	Lime-Shale		
2158	2213	Shale-Lime		
2213	2220	Shale-Lime		
2220	2660	Shale-Lime	2850' - 0°	
2660	2750	Shale-Lime		
2750	2905	Lime-Shale		
2905	2970	Lime		
2970	3080	Lime-Shale		
3080	3140	Lime-Shale		
3140	3200	Lime	3172' - 0°	
3200	3255	Lime		
3255	3300	Lime		
3300	3360	Lime		
3360	3400	Lime		
3400	3440	Lime		
3440	3477	Lime		
3477	3525	Lime		
3525	3535	Lime		
3535	3620	Lime-Chert		
3620	3660	Lime		
3660	3690	Lime		

Ran Electric Log

CASING LIFT IN HOE AFTER COMPLETION

Set 229.55' (10 lbs.) 6-5/8" OD Surface Casing.

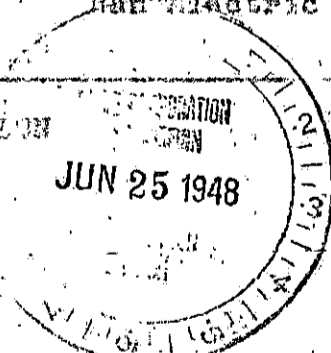

STATE OF KANSAS)
 COUNTY OF STAFFORD)

The undersigned certifies that to the best of his knowledge and belief the above facts are true and correct.

G-G DRILLING COMPANY, Inc.

By R. A. Cook, Pres.

Subscribed and sworn to before me this 23rd day of June, 1948.

My commission expires:
 June 25, 1951

Vicky Lutz
 Notary Public

PLUGGING
 JUL 20 3 12 PM '48
 BOOK PAGE 40 UNIT 12