


WELL PLUGGING RECORD

Give All Information Completely
Make Required Affidavit
Mail or Deliver Report to:
Conservation Division
State Corporation Commission
211 No. Broadway
Wichita, Kansas

NORTH

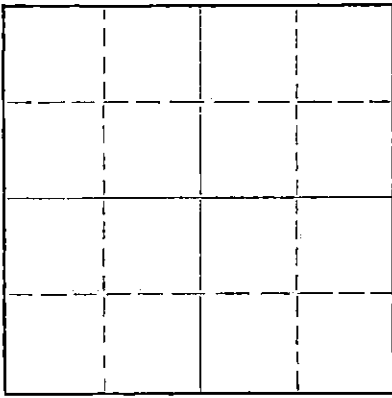

Locate well correctly on above
Section Plat

Stafford County. Sec. 34 Twp. 21S. Rge. 12 W. (E) (W)
Location as "NE/CNW/SW" or footage from lines SE SE SW
Lease Owner E. H. Adair & Lee Phillips
Lease Name Wittrock Well No. 1.
Office Address 1005 E. Second St. Wichita 7, Kans. (Adair)
Character of Well (completed as Oil, Gas or Dry Hole) an oil well.
Date well completed 1-15 19 54
Application for plugging filed 12-9 19 57
Application for plugging approved 12-9 19 57
Plugging commenced 12-9 19 57
Plugging completed 12-9 19 57
Reason for abandonment of well or producing formation Depleted.

If a producing well is abandoned, date of last production 12-8 19 57
Was permission obtained from the Conservation Division or its agents before plugging was commenced? Yes.

Name of Conservation Agent who supervised plugging of this well Eldon Petty, (address: Hays, Kans.)
Producing formation _____ Depth to top _____ Bottom _____ Total Depth of Well 3612 Feet
Show depth and thickness of all water, oil and gas formations. (RT.D.)

OIL, GAS OR WATER RECORDS

CASING RECORD

FORMATION	CONTENT	FROM	TO	SIZE	PUT IN	PULLED OUT
(Copy of driller's log attached hereto.)						

Describe in detail the manner in which the well was plugged, indicating where the mud fluid was placed and the method or methods used in introducing it into the hole. If cement or other plugs were used, state the character of same and depth placed, from _____ feet to _____ feet for each plug set.

Put 15 sax. mud at 435 feet; 90 sacks cement at 280 feet; cement to top of hole.

RECEIVED
STATE CORPORATION COMMISSION
DEC 21 1957
CONSERVATION DIVISION
Wichita, Kansas

(If additional description is necessary, use BACK of this sheet)

Name of Plugging Contractor E. H. Adair Oil Company
Address 1005 East Second Street, Wichita 7, Kansas.

STATE OF KANSAS, COUNTY OF SEDGWICK, ss.
K. W. JOHNSON (employee of owner) or (owner or operator) of the above-described well, being first duly sworn on oath, says: That I have knowledge of the facts, statements, and matters herein contained and the log of the above-described well as filed and that the same are true and correct. So help me God.

(Signature) K. W. Johnson
1005 E. Second St., Wichita 7, Kansas. K. W. Johnson.
(Address)

SUBSCRIBED AND SWORN TO before me this 18th day of December, 19 57.

My commission expires Sept. 15, 1961.

L. Hill Notary Public.

PLUGGING
FILE SEC. 34T 21 R 2 W
BOOK PAGE 59 LINE 26

E. H. Adair Oil Company
 1005 East Second Street
 Wichita 7, Kansas.

E. H. Adair Oil Company &
 Lee Phillips
 Wittrock #1
 SE SE SW
 Sec. 34-Twp. 21 S., R. 12 W.,
 Stafford County, Kansas.
 Elev.: 1853: K.B.

Comm.: 1-7-54
 Comp.: 1-15-54
 Contractor:
 E. H. Adair
 8-5/8 csg. @ 312 ft.
 w/200 sax cement.
 5-1/2 csg. @ 3610 ft.
 w/100 sax cement.

Pro. Swabbed 3-1/2 BOPH-
 Natural.

Depths indicate bottom of formations, K.B. Measurement.


Sand	to	130	Lime, porous	to	3359
Shale & shells		280	Lime, cherty		3371
Red shale		312	Lime, porous		3377
Shale		635	Lime		3413
Anhydrite		680	Lime, oolitic		3419
Shale		1450	Lime, dense		3429
Lime		1720	Lime, sl. porous		3437
Shale	to	1755	Lime, dense		3469
Lime & shale		2168	Shale		3472
Shale		2345	Lime		3516
Shale & shells		2745	Shale		3529
Shale		2870	Lime		3540
Lime & shale		2883	Chert		3563
Lime		2970	Shale		3596
Shale		3004	Sandy shale		3599
Lime, cherty		3033	Shale		3608
Lime, porous		3063	Dolomite		3612
Lime		3129	R.T.D.		3612
Black shale		3134			
Dense lime		3138			
Shale		3145			
Lime		3168			
Shale		3264			
Lime, brown, dense		3270			
Shale		3276			
Lime		3342			
Lime w/streaks of shale		3355			

RECEIVED
 STATE CORPORATION COMMISSION
 DEC 21 1957
 CONSERVATION DIVISION

Geological Tops

HEEBNER	3129-1276
BROWN LIME	3264-1411
LANSING-K.C.	3276-1423
VIOLA CHERT	3540-1687
SIMPSON SHALE	3563-1710
ARBUCKLE	3608-1755

D.D. with cable-tools, 3612-19. Swabbed 3-1/2 BOPH, no water, natural.

Certified correct:

 K. W. Johnson - Geologist.

PLUGGING
 FILE SEC 34 T 21 R 12 W
 BOOK PAGE 59 LINE 26