


WELL PLUGGING RECORD

Give All Information Completely
Make Required Affidavit
Mail or Deliver Report to:
Conservation Division
State Corporation Commission
800 Bitling Building
Wichita, Kansas

Stafford County, Sec. 34 Twp 21 Rge. 12 (W)
Location as "NE/CNW $\frac{1}{4}$ /SW $\frac{1}{4}$ " or footage from lines SE SE NE
Lease Owner E. H. Adair
Lease Name Siefkes Well No. 1
Office Address 407 W-K-H Building
Character of Well (completed as Oil, Gas or Dry Hole) Dry Hole
Date well completed May 13, 19 53
Application for plugging filed May 14, 19 53
Application for plugging approved May 14, 19 53
Plugging commenced May 14, 19 53
Plugging completed May 14, 19 53
Reason for abandonment of well or producing formation Barren
If a producing well is abandoned, date of last production 19
Was permission obtained from the Conservation Division or its agents before plugging was commenced? Yes

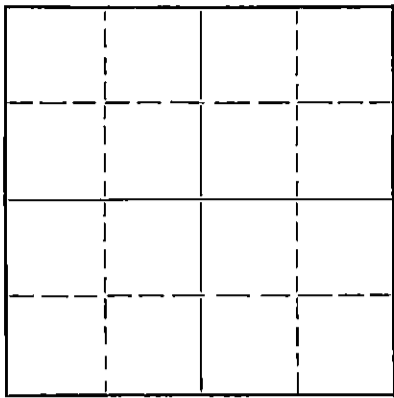

Locate well correctly on above Section Plat

Name of Conservation Agent who supervised plugging of this well
Producing formation Depth to top Bottom Total Depth of Well 3634 Feet
Show depth and thickness of all water, oil and gas formations.

OIL, GAS OR WATER RECORDS

CASING RECORD

Formation	Content	From	To	Size	Put In	Pulled Out
COPY OF WELL LOG ATTACHED						

Describe in detail the manner in which the well was plugged, indicating where the mud fluid was placed and the method or methods used in introducing it into the hole. If cement or other plugs were used, state the character of same and depth placed, from feet to feet for each plug set.

PLACED PLUG AT 270 FEET PUT 20 SACKS CEMENT ON PLUG
FILLED HOLE UP WITH MUD TO 35 FEET OF SURFACE. PLACED
PLUG AND PUT 10 SACKS IN HOLE FILLING HOLE UP TO SURFACE.

(If additional description is necessary, use BACK of this sheet)
Name of Plugging Contractor E. H. ADAIR OIL COMPANY
Address 407 W-K-H Building Wichita, Kansas

STATE OF Kansas, COUNTY OF Sedgwick, ss.
Kenneth W. Johnson (employee of owner) or (owner or operator) of the above-described well,

being first duly sworn on oath, says: That I have knowledge of the facts, statements, and matters herein contained and the log of the above-described well as filed and that the same are true and correct. So help me God.

(Signature) Kenneth W. Johnson
Wichita, Kansas (Address)

SUBSCRIBED AND SWORN to before me this 21st day of May, 1953
Notary Public.

My commission expires September 15, 1953. 23-8390-s 6-51-20M

PLUGGING
FILE 200-347-21-12W
BOOK PAGE 12637-44
CONSERVATION DIVISION
Wichita, Kansas
5-22-1953

L-0-G

E. H. ADAIR OIL COMPANY

SIEFKES # 1

Commenced: May 2, 1953

SE-SE-NE Section 34, T.21, R. 12-

Stafford County, Kansas

Elevation: 1842 K. B.

Sand	0-90	
Shale	90-321	
Shale	322-882	
Shale	882-1347	
Shale	1347-1560	
Lime	1560-1592	
Lime	1592-1792	
Lime & Shale	1792-1926	
Shale	1926-2027	
Shale	2027-2199	
Shale & Shells	2199-2329	
Shale	2329-2525	
Shale & Shells	2525-2675	
Shale & Shells	2675-2805	
Shale & Shells	2805-2879	
Lime	2879-2960	
Lime	2960-3067	
Lime & Shale	3067-3123	
Shells & Shale	3123-3177	
Shale & Shells	3177-3287	
Lime	3287-3357	
Lime	3357-3410	
Lime	3410-3447	- - Lime 3447-3510
Shale Simpson	3592-3676	Cong 3510-3538
Arbuckle	3616-3622	Cong 3538-3592
Arbuckle	3622-3629	
Arbuckle	3629-3634	T.D.

CERTIFIED CORRECT

Kenneth W. Johnson
Kenneth W. Johnson

RECEIVED
STATE OF KANSAS
GEOLOGICAL SURVEY

PLUGGING
FILE SEC-34 T 21 R 124
BOOK PAGE 101 LINE 44