


WELL PLUGGING RECORD

Give All Information Completely  
Make Required Affidavit  
Mail or Deliver Report to:  
Conservation Division  
State Corporation Commission  
212 North Market, Insurance Bldg.  
Wichita, Kansas

Stafford County, Sec. 12 Twp. 21 Rge. 12 (E) (W)  
SE/SE/SE

Location as "NE/CNW/SW" or footage from lines \_\_\_\_\_  
Lease Owner: Quality Supply Company  
Lease Name: Schrepel Well No. 1  
Office Address: 202 Petroleum Building, Wichita, Kansas  
Character of Well: 701 Union Hall (completed as Oil, Gas or Dry Hole)  
Date well completed \_\_\_\_\_ 19\_\_\_\_  
Application for plugging filed \_\_\_\_\_ 19\_\_\_\_  
Application for plugging approved \_\_\_\_\_ 19\_\_\_\_  
Plugging commenced \_\_\_\_\_ 7-28 19 61  
Plugging completed \_\_\_\_\_ 7-31 19 61  
Reason for abandonment of well or producing formation \_\_\_\_\_

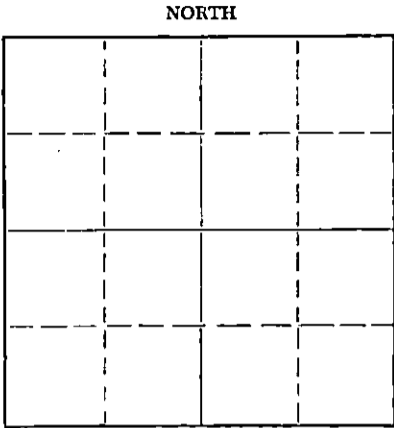

Locate well correctly on above Section Plat

If a producing well is abandoned, date of last production \_\_\_\_\_ 19\_\_\_\_  
Was permission obtained from the Conservation Division or its agents before plugging was commenced? Yes

Name of Conservation Agent who supervised plugging of this well Frank Broadfoot  
Producing formation \_\_\_\_\_ Depth to top \_\_\_\_\_ Bottom \_\_\_\_\_ Total Depth of Well 3517 Feet  
Show depth and thickness of all water, oil and gas formations.

OIL, GAS OR WATER RECORDS

CASING RECORD

FORMATION	CONTENT	FROM	TO	SIZE	PUT IN	PULLED OUT
				8 5/8"	531'	None
				5 1/2"	3481'	2662'

Describe in detail the manner in which the well was plugged, indicating where the mud fluid was placed and the method or methods used in introducing it into the hole. If cement or other plugs were used, state the character of same and depth placed, from \_\_\_\_\_ feet to \_\_\_\_\_ feet for each plug set.

Plug @ 3450'  
Top Perforation 3263

Sanded to 3250' - dumped 5 sks cement - pulled casing - mudded hole to 250' - set 10' rock bridge - dumped 20 sks cement - mudded to 35' - set 10' rock bridge - dumped 10 sks cement

RECEIVED  
STATE CORPORATION COMMISSION

AUG 29 1961

CONSERVATION DIVISION  
Wichita, Kansas

(If additional description is necessary, use BACK of this sheet)  
Name of Plugging Contractor: R & D Casing Pulling Company License # 236  
Address: Box # 572, Hutchinson, Kansas

STATE OF Kansas, COUNTY OF Sedgewick, ss.  
Jack Shear (employee of owner) or (owner or operator) of the above-described well, being first duly sworn on oath, says: That I have knowledge of the facts, statements, and matters herein contained and the log of the above-described well as filed and that the same are true and correct. So help me God.

(Signature) Jack Shear  
701 Union Hall Bldg. Wichita, Kans. (Address)

SUBSCRIBED AND SWORN to before me this 21 day of August, 1961

My commission expires Dec. 27, 1962  
Evelyn W. North Notary Public.



## CONTRACTOR'S VERIFIED LOG

Operator Sohio Petroleum Company Farm Name Schrepel Well No. 1  
 Location SE SE SE 12-21S-12W  
 Pool Name Wildcat County Stafford State Kansas  
 Commencement Date June 8, 1947 Completion Date June 22, 1947

## LOG OF WELL

Depth		Formation	Deviation from Vertical (Degrees)	Remarks
From	To			
0	5	Rig Foundation		Syfo 500 Ft. O.K.
5	150	Sand		Set 531' of 8 5/8" casing derrick floor.
150	235	Shale & Shells		Cemented with 350 sacks bulk cement. Syfo 1000' Ok
235	593	Red Bed		Syfo 1500' O.K.
593	620	Anhydrite		Syfo 2500' O.K.
620	1075	Shale & Shells		Syfo 3000' O.K.
1075	1255	Salt & Shale		
1255	1575	Shale Shells		
1575	1715	Broken Line		
1715	1830	Line		Ran Halliburton test at 3283'. Packer set at 3263'. 500' out oil and mud in 10 minute test.
1830	1910	Broken Line		
1910	2710	Shale & Shells		
2710	2765	Shale		
2765	2975	Broken Line		
2975	3040	Line		
3040	3085	Broken Line		
3085	3170	Shale		
3170	3178	Brown Line		
3178	3186	Shale		
3186	3422	Lansing Line		
3422	3465	Conglomerate		
3465	3482	Shale		
3482	3517	Arbuckle Line		
Total Depth				

Ran Schlumberger test at 3517'. Good test.

Set 3481' of 5 1/2" casing derrick floor. Cemented with 125 sacks cement.

**RECEIVED**  
STATE CORPORATION COMMISSION

JUL 17 1961

CONSERVATION DIVISION  
Wichita, Kansas

