

STATE OF KANSAS
STATE CORPORATION COMMISSION

Form CP-4

Give All Information Completely
Make Required Affidavit
Mail or Deliver Report to:
Conservation Division
State Corporation Commission
212 No. Market
Wichita, Kansas

WELL PLUGGING RECORD

Stafford

County. Sec. 12 Twp. 21 Rge. 12 West (X) (W)

Location as "NE/CNW%SW%" or footage from lines 150' No. of SE NW SW

Lease Owner Duke Drilling Co., Inc.

Lease Name HEWITT

Well No. 1

Office Address Box 823 - Great Bend, Kansas 67530

Character of Well (completed as Oil, Gas or Dry Hole) Dry Hole

Date well completed January 1 19 70

Application for plugging filed January 1 19 70

Application for plugging approved Jan. 1 19 70

Plugging commenced Jan. 1 19 70


Plugging completed Jan 1 19 70

Reason for abandonment of well or producing formation _____

If a producing well is abandoned, date of last production _____ 19 _____

Was permission obtained from the Conservation Division or its agents before plugging was commenced? yes

NORTH

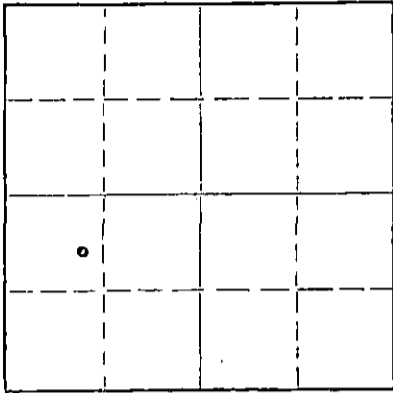

Locate well correctly on above Section Plat

Name of Conservation Agent who supervised plugging of this well Herman Justice

Producing formation _____ Depth to top _____ Bottom _____ Total Depth of Well 3496 Feet

Show depth and thickness of all water, oil and gas formations.

OIL, GAS OR WATER RECORDS

CASING RECORD

FORMATION	CONTENT	FROM	TO	SIZE	PUT IN	PULLED OUT

Describe in detail the manner in which the well was plugged, indicating where the mud fluid was placed and the method or methods used in introducing it into the hole. If cement or other plugs were used, state the character of same and depth placed, from _____ feet to _____ feet for each plug set.

Hole full of heavy mud.
Set Plug at 500' - 50 sacks cement thru d.p. with pump truck
Come up hole to 250' - 25 sacks cement thru d.p. with pump truck
Come up hole to 40' - Plug - good bridge 10 sacks cement
2 sacks cement in rat hole.

RECEIVED
STATE CORPORATION COMMISSION
JAN 5 1969
CONSERVATION DIVISION
Wichita, Kansas

(If additional description is necessary, use BACK of this sheet)

Name of Plugging Contractor _____
Address _____

STATE OF Kansas, COUNTY OF BARTON, ss.
Larry Curtis (employee of owner) or (~~owner~~) of the above-described

well, being first duly sworn on oath, says: That I have knowledge of the facts, statements, and matters herein contained and the log of the above-described well as filed and that the same are true and correct. So help me God.

(Signature) Larry Curtis
Box 823 - Great Bend, Kansas
(Address)

SUBSCRIBED AND SWORN TO before me this 2nd day of January, 19 70

Dorothy M. Hogue
Notary Public.

My commission expires 4-11-70

DRILLERS' WELL LOG

DATE COMMENCED: December 21, 1969
DATE COMPLETED: January 1, 1970

Duke Drilling Co., Inc.
HEWITT #1
150' No. of SE NW SW
Sec. 12-T21s-R12 West
Stafford County, Kansas

0	-	235'	Sand
235	-	594'	Red Bed
594	-	612'	Anhydrite
612	-	1060'	Shale
1060	-	1545'	Shale & Shells
1545	-	1710'	Shale & Lime
1710	-	2050'	Lime & Shale
2050	-	2475'	Shale
2475	-	2765'	Lime & Shale
2765	-	3063'	Lime
3063	-	3068'	Shale
3068	-	3084'	Lime & Shale
3084	-	3097'	Lime
3097	-	3192'	Shale
3192	-	3206'	Lime & Shale
3206	-	3431'	Lime
3431	-	3470'	Lime & Shale
3470	-	3486'	Conglomerate
3486	-	3496'	Dolomite

ELEVATION: 1834 K.B.

FORMATION TOPS

ANHYDRITE	594
HEEBNER	3063
TORONTO	3084
DOUGLAS	3097
BROWN LIME	3192
KANSAS CITY	3206
BASE K.C.	3431
CONGLOMERATE	3470
ARBUCKLE	3486
RTD	3496

RECEIVED
STATE CORPORATION COMMISSION
JAN 5 1969
CONSERVATION DIVISION
Wichita, Kansas

SURFACE CASING: Set 330'
of new 20# 8-5/8" casing
with 275 sacks cement.

A F F I D A V I T

STATE OF KANSAS
COUNTY OF BARTON) ss.

Larry Curtis of lawful age does swear and state that the facts and statements herein contained are true and correct to the best of his knowledge.

Larry Curtis

Subscribed and sworn to before me this 2nd day of January, 1970.

My Comm. Expires:
April 11, 1970

Dorothea M. Hagire
Notary Public