


STATE OF KANSAS  
STATE CORPORATION COMMISSION

WELL PLUGGING RECORD

Give All Information Completely  
Make Required Affidavit  
Mail or Deliver Report to:  
Conservation Division  
State Corporation Commission  
211 No. Broadway  
Wichita, Kansas

Stafford County. Sec. 12 Twp. 21 Rge. 12 (E) (W)  
Location as "NE/CNW/SE" or footage from lines Center of W/2 SE NE  
Lease Owner Duke Drilling Company  
Lease Name Hall Well No. 1  
Office Address P. O. Box 823 Great Bend, Kansas  
Character of Well (completed as Oil, Gas or Dry Hole) \_\_\_\_\_  
Date well completed \_\_\_\_\_ 19\_\_\_\_  
Application for plugging filed 9-24-64 19\_\_\_\_  
Application for plugging approved 9-25-64 19\_\_\_\_  
Plugging commenced 11-9-64 19\_\_\_\_  
Plugging completed 11-16-64 19\_\_\_\_  
Reason for abandonment of well or producing formation \_\_\_\_\_  
Dry  
If a producing well is abandoned, date of last production \_\_\_\_\_ 19\_\_\_\_  
Was permission obtained from the Conservation Division or its agents before plugging was commenced? Yes

NORTH

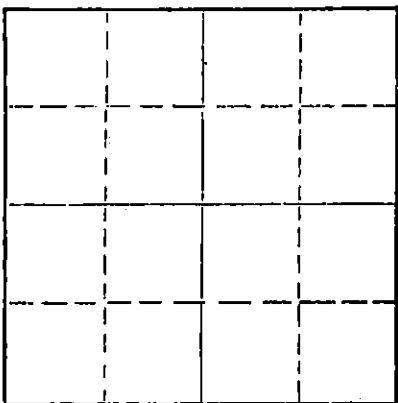

Locate well correctly on above  
Section Plat

Name of Conservation Agent who supervised plugging of this well Archie V. Elving  
Producing formation \_\_\_\_\_ Depth to top \_\_\_\_\_ Bottom \_\_\_\_\_ Total Depth of Well 3500 Feet  
Show depth and thickness of all water, oil and gas formations.

OIL, GAS OR WATER RECORDS

CASING RECORD

FORMATION	CONTENT	FROM	TO	SIZE	PUR IN	PULLED OUT
				8 5/8	283	None
				5 1/2	None	2525

Describe in detail the manner in which the well was plugged, indicating where the mud fluid was placed and the method or methods used in introducing it into the hole. If cement or other plugs were used, state the character of same and depth placed, from \_\_\_\_\_ feet to \_\_\_\_\_ feet for each plug set.

Cleaned out cellar. Sanded to 3100'. Dumped 5 sacks of cement.  
Working pipe.

Working pipe. Shot pipe at 2800' - 2700' - 2600' & 2515'.  
Pulling pipe.

Pulling pipe. Bailing water. Push plug to 260'. Build rock  
bridge. Dumped 10 sacks of cement.

Plugging well. Bailed to 260'. Dumped 15 sacks of cement.  
Filled hole and rock bridge. Capped well with 10 sacks of cement.

RECEIVED  
STATE CORPORATION COMMISSION

NOV 18 1964

CONSERVATION DIVISION  
Wichita, Kansas

(If additional description is necessary, use BACK of this sheet)

Name of Plugging Contractor Forbes Casing Pulling, Inc.  
Address P. O. Box 221 Great Bend, Kansas

STATE OF Kansas, COUNTY OF Barton, ss.

J. O. Forbes

(employee of owner) or (owner or operator) of the above-described

well, being first duly sworn on oath, says: That I have knowledge of the facts, statements, and matters herein contained and the log of the above-described well as filed and that the same are true and correct. So help me God.

(Signature)

J. O. Forbes  
P. O. Box 221 Great Bend, Kansas  
(Address)

Subscribed and sworn to before me this 17 day of November, 1964

Glenn Baker

Notary Public.

My commission expires May 27, 1965

WELL LOG

Date Started: April 26, 1959  
Date Completed: May 6, 1959

Edd Hall #1  
C W/2 of SE NE  
Section 12-21-12  
Stafford County, Kansas

Elevation	1817'	K.B.
Anhydrite	556'	-1261
Heebner	3031'	-1214
Brown Lime	3158'	-1341
Lansing	3176'	-1359
Simpson Sand	3430'	-1613
Arbuckle	3454'	-1637
R.T.D.	3500'	-1683

0'	- 200'	Sand Shells
200'	- 230'	Shale
230'	- 260'	Red Bed Shale
260'	- 270'	Sand
270'	- 283'	Red Bed Shale
283'	- 556'	Red Bed
556'	- 584'	Anhydrite
584'	- 725'	Shale and Shells
725'	- 1300'	Shale and Shells
1300'	- 1450'	Salt and Shale
1450'	- 1550'	Shale and Shells
1550'	- 1650'	Shale and Lime Streak
1650'	- 1810'	Lime Shale
1810'	- 2245'	Lime and Shale
2245'	- 2655'	Lime and Shale
2655'	- 2945'	Lime and Shale
2945'	- 3031'	Lime and Shale
3031'	- 3158'	Heebner
3158'	- 3176'	Lime
3176'	- 3290'	Lansing
3290'	- 3405'	Lime
3405'	- 3430'	Lime
3430'	- 3440'	Simpson Sand
3440'	- 3454'	Lime
3454'	- 3500'	Arbuckle
3500'		R.T.D.

**RECEIVED**  
STATE CORPORATION COMMISSION

DEC 22 1964

CONSERVATION DIVISION  
Wichita, Kansas

AFFIDAVIT

State of Kansas . . . . . County of Barton

I, Cecil M. Olson, employee of the owner, do swear that the statements and matter herein contained are true to the best of my knowledge.

THE DUKE DRILLING COMPANY

BY: C. Olson

Subscribed and sworn before me this 2nd day of June, 1959.

John E. Stinson  
NOTARY PUBLIC

My commission expires: June 24, 1959