

STATE OF KANSAS  
STATE CORPORATION COMMISSION


Give All Information Completely  
Make Required Affidavit  
Mail or Deliver Report to:  
Conservation Division  
State Corporation Commission  
212 No. Market  
Wichita, Kansas

WELL PLUGGING RECORD

Stafford County. Sec. 12 Twp. 21S Rge. (X) 12 (W)

Location as "NE/CNW/SW" or footage from lines SW NE NW  
Lease Owner Clinton Oil Company  
Lease Name D. Hall "B" Well No. 2-D  
Office Address 217 N. Water, Wichita, Kansas 67202  
Character of Well (completed as Oil, Gas or Dry Hole) Dry Hole  
Date well completed 10/24 1969  
Application for plugging filed 10/31 1969  
Application for plugging approved 10/29 1969  
Plugging commenced 10/24 1969  
Plugging completed 10/24 1969  
Reason for abandonment of well or producing formation Dry Hole

NORTH

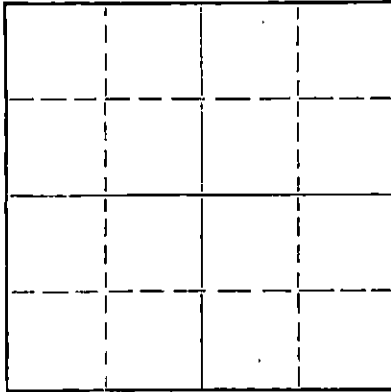

Locate well correctly on above Section Plat

If a producing well is abandoned, date of last production N/A 19  
Was permission obtained from the Conservation Division or its agents before plugging was commenced? Yes

Name of Conservation Agent who supervised plugging of this well R. J. Warren, Box 322, Pratt, Kansas  
Producing formation None Depth to top N/A Bottom N/A Total Depth of Well 3530 Feet  
Show depth and thickness of all water, oil and gas formations.

OIL, GAS OR WATER RECORDS

CASING RECORD

FORMATION	CONTENT	FROM	TO	SIZE	PUT IN	PULLED OUT
Anhydrite		605		8 5/8"	289'	
Howard		2678				
Topeka		2775				
Heebner		3051				
Brown Lime		3183				
Lansing		3192				
Kansas City "B" Zone		3215				
Conglomerate		3429				

Describe in detail the manner in which the well was plugged, indicating where the mud fluid was placed and the method or methods used in introducing it into the hole. If cement or other plugs were used, state the character of same and depth placed, from \_\_\_\_\_ feet to \_\_\_\_\_ feet for each plug set.

Filled hole w/heavy rotary mud. Set plug at 450' w/50 Sx of cement. At 275', set plug w/25 Sx cement. With 1/2 sack hulls & 10 Sx of cement set plug @ 40'. 2 Sx in rat hole and 2 sx in mousehole.

RECEIVED  
STATE CORPORATION COMMISSION  
JAN 9 1970  
CONSERVATION DIVISION  
Wichita, Kansas


(If additional description is necessary, use BACK of this sheet)

Name of Plugging Contractor Garvey Drilling Company  
Address Route #2, Great Bend, Kansas 67530

STATE OF Kansas, COUNTY OF Sedgwick, ss.  
Earl E. Rossman, Jr. (employee of owner) or (owner) of the above-described well, being first duly sworn on oath, says: That I have knowledge of the facts, statements, and matters herein contained and the log of the above-described well as filed and that the same are true and correct. So help me God.

(Signature) *Earl E. Rossman, Jr.*  
Proration & Unitization Engineer  
217 N. Water, Wichita, Kansas 67202 (Address)

Subscribed and sworn to before me this 8th day of January, 1970

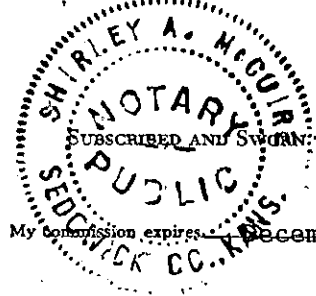

*Shirley A. McGuire*  
Shirley A. McGuire Notary Public.

# WELL LOG

15.185.20223.0000

COMPANY Clinton Oil Company

SEC. 12 T. 21S R. 12W

FARM E. B. Hall "B" NO. 2-D

LOC. SW NE NW

TOTAL DEPTH 3530'

COUNTY Stafford, Kansas

COMM. 10-18-69 COMP. 10-27-69

CONTRACTOR Garvey Drilling Company

RECEIVED  
STATE CORPORATION COMMISSION  
JAN 9 1970  
CONSERVATION DIVISION  
Wichita, Kansas


CASING  
8 5/8" @ 289' w/225sx

ELEVATION

PRODUCTION D & A

FIGURES INDICATE BOTTOM OF FORMATIONS

- 245' Sand
- 290' Red Bed
- 627' Anhydrite
- 1330' Shale & Shells
- 1650' Shale & Lime
- 1920' Lime & Shale
- 2104' Lime
- 2385' Lime & Shale
- 2725' Shale & Lime
- 2990' Lime
- 3060' Lime & Shale
- 3115' Shale
- 3228' Lime
- 3460' Chert, Shale, & Lime
- 3485' Conglomerate & Shale
- 3520' Lime, Shale, & Chert
- 3530' Chert
- 3530' RTD

State of Kansas }  
County of Barton } ss

I, Charlene Marker of Garvey Drilling Company

upon oath state the above and foregoing is a true and correct copy of the log of the E. B. Hall "B" No. 2-D well.

Charlene Marker

Subscribed and sworn to before me this 5th day of November 19 69

My Commission Expires: November 5, 1973

Richard Hoops  
NOTARY PUBLIC