


Give All Information Completely  
Make Required Affidavit  
Mail or Deliver Report to:  
Conservation Division  
State Corporation Commission  
800 Bittig Building  
Wichita, Kansas

WELL PLUGGING RECORD

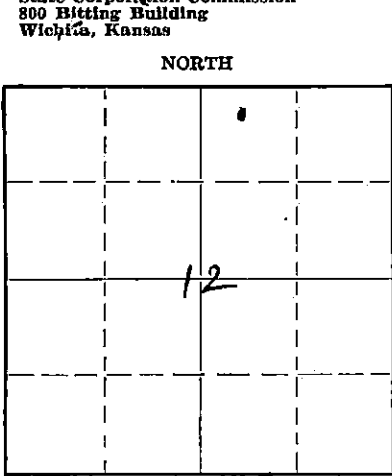

Stafford County. Sec. 12 Twp. 21 Rge. (E) 12 (W)  
Location as "NE/CNW/SW" or footage from lines C-N<sup>1</sup>-NW-NE  
Lease Owner Hal & Prather, - Sterling Drg, Et, Al.  
Lease Name E.B. Hall Well No. 1  
Office Address Box # 131 Great Bend, Kansas  
Character of Well (completed as Oil, Gas or Dry Hole) D & A  
Date well completed Dec. 7th, 19 51  
Application for plugging filed Dec. 7th, 19 51  
Application for plugging approved same 19  
Plugging commenced Dec 8th, 19 51  
Plugging completed Dec, 30th, 19 51  
Reason for abandonment of well or producing formation  
Dry Hole

If a producing well is abandoned, date of last production 19  
Was permission obtained from the Conservation Division or its agents before plugging was commenced? Mr. C.D. Stough, Gt bend, by phone.

Name of Conservation Agent who supervised plugging of this well Same as above  
Producing formation Arbuckle dolomite Depth to top 3492 Bottom 3494 1/2 Total Depth of Well 3525 Feet  
Show depth and thickness of all water, oil and gas formations. Measurements to Rotary bushing or corrected to same

OIL, GAS OR WATER RECORDS

CASING RECORD

Formation	Content	From	To	Size	Put In	Pulled Out
<del>SMITH</del> Sand & Shale	Fresh water	0'	225'	8 5/8	253'	Circulated
Arbuckle	show oil	3492	3494 1/2	5 1/2	3493	3150'
The above was cemented with 60 sacks Reg cement.						

Describe in detail the manner in which the well was plugged, indicating where the mud fluid was placed and the method or methods used in introducing it into the hole. If cement or other plugs were used, state the character of same and depth placed, from feet to feet for each plug set.

River gravel to 3475' Dumped 5 sacks reg. cement on same Top cement 3432'  
Mudded hole to 250' Rock bridge and 15 sacks cement on same, Top cement 200'  
Mud to 35' Rock bridge at 35', 10 sacks cement for cap,

JAN 7 1952  
1-17-52

(If additional description is necessary, use BACK of this sheet)

Correspondence regarding this well should be addressed to Cecil A. Prather, Box # 131, Great Bend, Kansas

STATE OF Kansas, COUNTY OF Barton, ss. Partner  
Cecil A. Prather (owner or operator) of the above-described well,  
being first duly sworn on oath, says: That I have knowledge of the facts, statements, and matters herein contained and the log of the above-described well as filed and that the same are true and correct. So help me God.

(Signature) Cecil A. Prather  
as above  
(Address)

SUBSCRIBED AND SWORN to before me this 16<sup>th</sup> day of January, 1952  
Helen M. Smith  
Notary Public.

My commission expires April 25, 1954  
22-5133-s 9-48-10M

PLUGGED  
FILE SEC 12 T21 R2W  
BOOK PAGE 135 LINE 7

*Free State*

WELL LOG ----- HALL #1

Location - NE/4 NW/4 NE/4 of Section 12-21-12, Stafford County, Kansas

Owner - Hall-Prather et al  
 Rotary Drilling Contractor - Group Exploration Company  
 Cable Tools Contractor - Hall Prather Drilling Co.

Commenced - 11-19-51  
 Completed - 12-1-51 (w/r)  
 - (w/c.t.)

Total Depth - 3494 (w/r)  
 - (w/c.t.)

ELEVATION: 1819 DF  
 1822 RB

LOG

0- 225 Sand and Shale  
 225- 240 Red Bed  
 240- 325 Shale  
 325- 600 Red Bed and Shale  
 600- 625 Anhydrite  
 625- 780 Red Bed  
 780-1200 Shale and Red Bed  
 1200-1350 Shale  
 1350-1570 Shale and Lime  
 1570-1670 Lime  
 1670-1820 Lime and Shale  
 1820-1975 Lime  
 1975-2670 Shale and Lime  
 2670-3040 Lime  
 3040-3187 Shale  
 3187-3355 Lime  
 3355-3410 Lime and Shale  
 3410-3440 Lime  
 3440-3494 Shale  
 3492-3494 Dolomite with oil show  
 3494-3512 Dense dolomite, 77 Gal. water overnight, at 3512'  
 3512-14 White Dolomite  
 3514-23 Dense Dolomite  
 3523-25 Dense Dolomite with 1/2 bailer black water per. hr.  
 3525 Total depth rotary-bushing measurement.

CASING RECORD

253' of 8-5/8" Surface Pipe  
 Cemented with 200 Sacks Bulk Cement  
 (300# Calcium Chloride) - 1' off bottom  
 3505.69' of 5 1/2" O. D. Casing  
 Set at 3491'. 60 Sacks Cement.  
 Tops R.B.M  
 Hebner 3045'  
 Brown Lime 3174'  
 White " 3188'  
 Conglomerate 3420'  
 Simpson 3439'  
 Arb. Dolomite 3492'  
 Total Depth 3525' RBM

FILE 58-12-17 (12)  
 BOOK PAGE 135 LINE 7

*302  
 312/10*

15.185.11755-0000

For

# MILLER CASING PULLING COMPANY

State  
Prather

POST OFFICE BOX 711

TELEPHONE 8762

GREAT BEND, KANSAS

Plugging Record For Hall & Prather, Hall Farm, Well #1:

Mudded hole to 250', set rock bridge, dumped 15 sax  
Top of cement 200'. Mudded hole to 35', set rock  
bridge at 35', dumped 10 sax for cap.

\*\*\*\*\*

Completion Date:12-30-51.

State Plugger: C.D. Stough  
Address: Great Bend, Kansas.

JAN 19 1952  
GREAT BEND, KANSAS