

WELL PLUGGING RECORD

Give All Information Completely  
Make Required Affidavit  
Mail or Deliver Report to:  
Conservation Division  
State Corporation Commission  
212 No. Market  
Wichita, Kansas

Stafford County, Sec. 33 Twp. 21S Rge. 12 (W)

Location as "NE/CNW/SW" or footage from lines NE NW SW

Lease Owner Abercrombie Drilling, Inc.

Lease Name Walker Well No. 1

Office Address 801 Union Center

Character of Well (completed as Oil, Gas or Dry Hole) Dry Hole

Date well completed December 1, 1966

Application for plugging filed (verbally) November 30, 1966

Application for plugging approved (verbally) November 30, 1966


Plugging commenced November 30, 1966

Plugging completed December 1, 1966

Reason for abandonment of well or producing formation Dry Hole

If a producing well is abandoned, date of last production 19

Was permission obtained from the Conservation Division or its agents before plugging was commenced? Yes

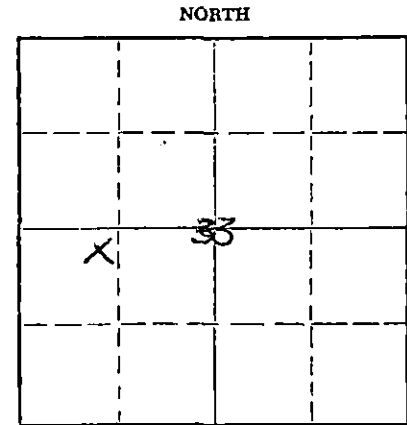

Locate well correctly on above Section Plat

Name of Conservation Agent who supervised plugging of this well Archie Elving, Pratt, Kansas

Producing formation \_\_\_\_\_ Depth to top \_\_\_\_\_ Bottom \_\_\_\_\_ Total Depth of Well 3363 Feet

Show depth and thickness of all water, oil and gas formations.

OIL, GAS OR WATER RECORDS

CASING RECORD

FORMATION	CONTENT	FROM	TO	SIZE	PUT IN	PULLED OUT
				8-5/8"	311'	None

Describe in detail the manner in which the well was plugged, indicating where the mud fluid was placed and the method or methods used in introducing it into the hole. If cement or other plugs were used, state the character of same and depth placed, from \_\_\_\_\_ feet to \_\_\_\_\_ feet for each plug set.

Filled hole with heavy mud up to 300'  
First plug 1/4 sack hulls and 25 sacks of cement.  
Filled hole with heavy mud up to 40'  
Second plug 1/2 sack of hulls and 10 sacks of cement.  
Two sacks of cement in rat hole.

RECEIVED  
DEC 5 1966  
CONSERVATION DIVISION  
WICHITA, KANSAS

(If additional description is necessary, use BACK of this sheet)

Name of Plugging Contractor Abercrombie Drilling, Inc.

Address 801 Union Center, Wichita, Kansas

STATE OF KANSAS, COUNTY OF SEDGWICK, ss.  
Jack K. Wharton (employee of owner) or (owner or operator) of the above-described well, being first duly sworn on oath, says: That I have knowledge of the facts, statements, and matters herein contained and the log of the above-described well as filed and that the same are true and correct. So help me God.

(Signature) Jack K. Wharton  
801 Union Center, Wichita, Kansas  
(Address)

SUBSCRIBED AND SWORN TO before me this 2nd day of December, 1966

My commission expires March 31, 1970.

Margo Dee Montgomery  
Margo Dee Montgomery  
Notary Public.

CONTRACTOR'S WELL LOG

COMPANY: Abercrombie Drilling, Inc.  
 CONTRACTOR: Abercrombie Drilling, Inc.  
 FARM: Walker #1  
 LOCATION: NE NW SW, Sec. 33-21S-12W  
 Stafford County, Kansas  
 COMMENCED: November 25, 1966  
 COMPLETED: December 1, 1966

0	40	Sand
40	320	Sand & Shale
320	373	Shale
373	674	Red Bed
674	705	Anhydrite
705	1605	Shale & Ls. Streaks
1605	2070	Lime & Shale
2070	2745	Shale
2745	3363	Lime & Shale
	3363	Rotary Total Depth

Set 8-5/8" surface casing at 311 feet with 275 sacks, 2% gel and 2% ccl.  
 Dry and abandoned.

Formation Tops:		Elevation:	1879 K.B.
			1878 D.F.
			1872 G.L.
Heebner	3166	(-1287)	
Toronto	3184	(-1305)	
Douglas	3197	(-1318)	
Brown Lime	3299	(-1420)	
Lansing	3309	(-1430)	
Rotary Total Dep.	3363	(-1484)	

RECEIVED  
 CONSERVATION COMMISSION  
 DEC 5 1966  
 CONSERVATION DIVISION  
 Wichita, Kansas


STATE OF KANSAS )  
 ) SS  
 COUNTY OF SEDGWICK )

I, Jack K. Wharton, do hereby certify that the above and foregoing is a true and correct copy of the log of the Walker #1, NE NW SW of Section 33-24S-12W, Stafford County, Kansas, as reflected by the files of Abercrombie Drilling, Inc.

*Jack K. Wharton*  
 Jack K. Wharton

Subscribed and sworn to before me, a Notary Public, in and for Sedgwick County, Kansas, this 2nd day of December, 1966.

*Margo Dee Montgomery*  
 Margo Dee Montgomery

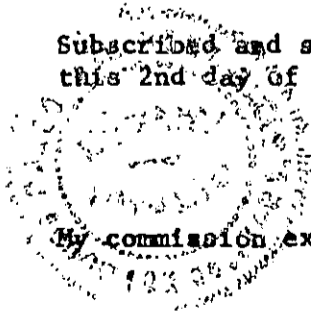

My commission expires March 31, 1970.