


Give All Information Completely
Make Required Affidavit
Mail or Deliver Report to:
Conservation Division
State Corporation Commission
800 Bitting Building
Wichita, Kansas

WELL PLUGGING RECORD

NORTH

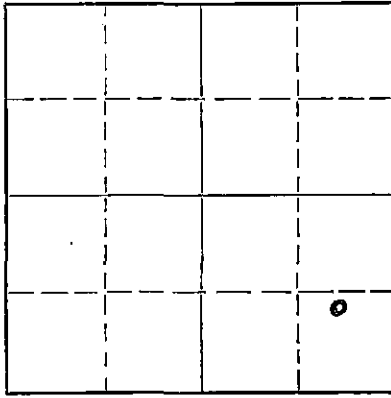

Locate well correctly on above
Section Plat

Stafford County. Sec. 33 Twp. 21 Rge. 12 (E) W (W)
Location as "NE/CNW/SW" or footage from lines CN/2 - SE - SE
Lease Owner Petroleum, Inc.
Lease Name Sittner "A" Well No. 1
Office Address 311 East 3rd Street, Wichita, Kansas
Character of Well (completed as Oil, Gas or Dry Hole) Oil
Date well completed February 12 19 50
Application for plugging filed November 2 19 54
Application for plugging approved November 4 19 54
Plugging commenced November 4 19 54
Plugging completed November 8 19 54
Reason for abandonment of well or producing formation Depletion of producible zones.
If a producing well is abandoned, date of last production November 2 19 54
Was permission obtained from the Conservation Division or its agents before plugging was commenced? Yes.

Name of Conservation Agent who supervised plugging of this well M. A. Rives
Producing formation Arbuckle Depth to top 3,652' Bottom - - Total Depth of Well 3,656' Feet
Show depth and thickness of all water, oil and gas formations.

OIL, GAS OR WATER RECORDS

CASING RECORD

FORMATION	CONTENT	FROM	TO	SIZE	PUT IN	PULLED OUT
<u>Arbuckle</u>	<u>Oil & Water</u>	<u>3,653'</u>	<u>3,656'</u>	<u>8-5/8"</u>	<u>230'</u>	<u>None</u>
				<u>5 1/2"</u>	<u>3,653'</u>	<u>3,070'</u>

Describe in detail the manner in which the well was plugged, indicating where the mud fluid was placed and the method or methods used in introducing it into the hole. If cement or other plugs were used, state the character of same and depth placed, from _____ feet to _____ feet for each plug set.

Filled hole from 3,656' to 3,640' with crushed rock, and placed 5 sacks cement from 3,640' to 3,600'. Mudded up with heavy mud from 3,600' to 230'. Set wooden plug at 230' and made solid rock bridge from 230' to 225', and placed 20 sacks cement on top of bridge. Mudded up to 35' and set second wooden plug, and filled hole to base of well cellar with 10 sacks cement.

(If additional description is necessary, use BACK of this sheet)

Name of Plugging Contractor Morgan Well Plugging Service.
Address 102 West 18th Street, Hutchinson, Kansas.

STATE OF Kansas, COUNTY OF Barton, SS.
Paul B. Shivel (employee of owner) or ~~GENERAL MANAGER~~ of the above-described well, being first duly sworn on oath, says: That I have knowledge of the facts, statements, and matters herein contained and the log of the above-described well as filed and that the same are true and correct. So help me God.

(Signature) Paul B Shivel

(Address)

SUBSCRIBED AND SWORN TO before me this 15th day of November 19 54

Ray E. Anderson
Notary Public.

My commission expires November 21, 1957

24-7368-5 3-53-20M

PLUGGING
FILE SEC 33 Twp. 21 R. 12W
BOOK PAGE 75 LINE 12

11-16-54

WELL LOG SITTNER NO. 1

Petroleum, Inc., Lease Owner

Section 33, Twp. 21S, Rge. 12W

Drillers, Inc., Contractor

Location N/2 SE SE

Rotary Total Depth: 3656'

County: Stafford, Kansas

Commenced: January 27, 1950

Completed: February 6, 1950

Production:

Casing: 255.81' of 8 5/8"
3652.83' of 5 1/2"

Elevation: 1864 D.F.

Figures below indicate bottom of formation

40	Surface soil & Shale	3615	Shale
120	Sand	3656	Lime
160	Sand & Gravel		
220	Shale & Sand	3656	Rotary Total Depth
230	Shale & Shells		
285	Red Bed		
685	Anhydrite		
1005	Shale & Shells	660	Anhydrite
1585	Shale & Lime	3152	Heebner
1825	Lime	3170	Toronto
2180	Lime & Shale	3285	Br. Lime
2520	Shale & Shells	3301	Lansing
2660	Lime & Shale	3515	B.K.C.
3110	Lime	3548	P.B.C.
3250	Shale & Shells	3553	Viola
3295	Shale	3594	Simpson
3345	Lime	3652	Arbuckle
3550	Viola		
3570	Lime & chert		
3595	Chert		

Tops

I hereby certify that this is a true and correct log of the above mentioned well.

PETROLEUM, INC.

Eric H. Jager
Eric H. Jager

STATE OF KANSAS
: SS.
SEDGWICK COUNTY

Subscribed to and sworn to before me, a Notary Public in said County and State this 14th day of February, 1950.

Margaret Bradshaw
Notary Public

My Commission Expires: October 27, 1952.

PLUGGING
WELL NO. 33-21R-12W
BOOK PAGE 25 LINE 12