15.185.12469.0000


Form CP-4

STATE OF KANSAS
STATE CORPORATION COMMISSION

Give All Information Completely
Make Required Affidavit
Mail or Deliver Report to:
Conservation Division
State Corporation Commission
212 No. Market
Wichita, Kansas

WELL PLUGGING RECORD

NORTH

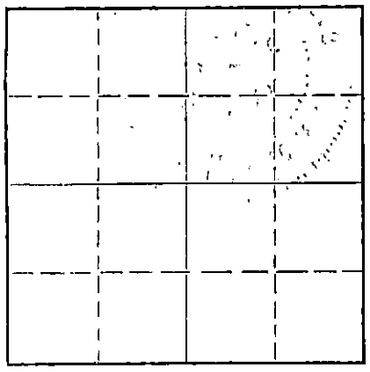

Locate well correctly on above Section Plat

Stafford County. Sec. 33 Twp. 21 Rge. 12 (E) ___ (W)

Location as "NE/CNW¼SW¼" or footage from lines NW NE NE

Lease Owner Meltzer Oil Company

Lease Name Sitner SWD Well No. 5

Office Address Great Bend, Kansas 67530

Character of Well (completed as Oil, Gas or Dry Hole) ___

Date well completed ___ 19___

Application for plugging filed ___ 19___

Application for plugging approved ___ 19___

Plugging commenced 5/26/69 19___

Plugging completed 5/28/69 19___

Reason for abandonment of well or producing formation depleted.

If a producing well is abandoned, date of last production ___ 19___

Was permission obtained from the Conservation Division or its agents before plugging was commenced? yes

Name of Conservation Agent who supervised plugging of this well Warren

Producing formation ___ Depth to top ___ Bottom ___ Total Depth of Well 3868 Feet

Show depth and thickness of all water, oil and gas formations.

OIL, CAS OR WATER RECORDS — CASING RECORD

FORMATION	CONTENT	FROM	TO	SIZE	PUT IN	PULLED OUT
				8-5/8	320	none
				5½"	3867'	1470

Describe in detail the manner in which the well was plugged, indicating where the mud fluid was placed and the method or methods used in introducing it into the hole. If cement or other plugs were used, state the character of same and depth placed, from ___ feet to ___ feet for each plug set.

Checked hole to 3868', ran sand to 3850' and dumped 5 sacks of cement. Shot pipe at 1465', pulled 47 joints. Set 10' rock bridge at 250' and dumped 5 sacks of cement. Bailed fluid down to top of plug, dumped 20 sacks of cement. Mudded to 40', set 10' rock bridge and dumped 10 sacks of cement. Moved off location.

PLUGGING COMPLETE.

RECEIVED
STATE CORPORATION COMMISSION
JUN 3 1969
CONSERVATION DIVISION
Wichita, Kansas

(If additional description is necessary, use BACK of this sheet)

Name of Plugging Contractor KNIGHT CASING PULLING CO., INC.

Address CHASE, KANSAS

STATE OF KANSAS, COUNTY OF RICE, ss.

NOEL J. KNIGHT (employee of owner) or (owner or operator) of the above-described well, being first duly sworn on oath, says: That I have knowledge of the facts, statements, and matters herein contained and the log of the above-described well as filed and that the same are true and correct. So help me God.

(Signature) Noel J. Knight

CHASE, KANSAS
(Address)

SUBSCRIBED AND SWORN TO before me this 29th day of May, 19 69

Margaret A. Melcher
Notary Public.

My commission expires Feb. 15, 1971

MARGARET A. MELCHER NOTARY PUBLIC RICE COUNTY, KANSAS

DRILLERS LOG

15.185.12469.0000

Artnell #5 Sittner
NW NE NE¼ 33-21S-12W.,
Stafford County, Kansas
Commenced: 9-16-46
Completed:

Elevation: 1854' Derrick floor

Casing Record:
10 3/4" 283'
5" 3867

All measurements are from the top of the rotary bushing, which is 1' above the derrick floor.

DEPTH	FORMATION
0- 40	Soil and sand
40- 130	Sand and clay
130- 280	Shale and red beds
280- 580	Red beds
580- 655	Red beds and shale
655- 680	Anhydrite
680-1020	Shale
1020-1175	Shale and shells
1175-1390	Shale and salt
1390-1500	Shale
1500-1545	Broken limestone
1545-1710	Limestone and shale
1710-1920	Limestone
1920-2415	Limestone and shale
2415-2485	Shale
2485-2780	Shale and shells
2780-2895	Shale and limestone
2895-3165	Limestone
3165-3260	Shale
3260-3491	Limestone
3491-3525	Chert and limestone
3525-3590	Cherty limestone
3590-3593	Limestone
3593-3636	Conglomerate
3636-3867	Arbuckle Limestone

Rotary Total Depth 3867'

RECEIVED
STATE CORPORATION COMMISSION
APR 28 1969
CONSERVATION DIVISION
Wichita, Kansas

This is a correct and complete copy of the drillers log as compiled from the daily drilling report furnished by the Sterling Drilling Company, drilling contractors on this well.

WENDELL S. JOHNS