


Give All Information Completely  
Make Required Affidavit  
Mail or Deliver Report to:  
Conservation Division  
State Corporation Commission  
211 No. Broadway  
Wichita, Kansas

WELL PLUGGING RECORD

NORTH

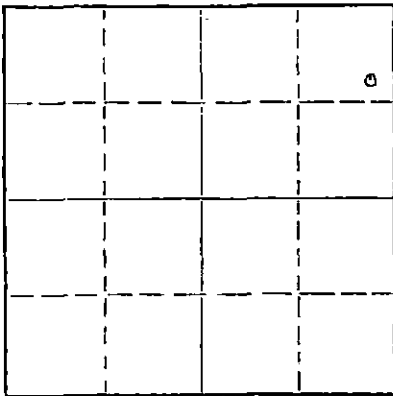

Locate well correctly on above  
Section Plat

Stafford County, Sec. 33 Twp. 21 Rge. (E) 12 (W)  
Location as "NE/CNW/SW" or footage from lines SE-NE-NE  
Lease Owner Great Bend Pipe & Supply  
Lease Name Sittner Well No. 2  
Office Address Great Bend, Kansas  
Character of Well (completed as Oil, Gas or Dry Hole)  
Date well completed 19\_\_\_\_  
Application for plugging filed 19\_\_\_\_  
Application for plugging approved 19\_\_\_\_  
Plugging commenced 5-6 1959  
Plugging completed 5-14 1959  
Reason for abandonment of well or producing formation

If a producing well is abandoned, date of last production 19\_\_\_\_  
Was permission obtained from the Conservation Division or its agents before plugging was commenced? Yes

Name of Conservation Agent who supervised plugging of this well Frank Broadfoot  
Producing formation \_\_\_\_\_ Depth to top \_\_\_\_\_ Bottom \_\_\_\_\_ Total Depth of Well 3614 Feet  
Show depth and thickness of all water, oil and gas formations.

OIL, GAS OR WATER RECORDS

CASING RECORD

FORMATION	CONTENT	FROM	TO	SIZE	PUT IN	PULLED OUT
				10 3/4	280	None
				7	3278	1784.20

Describe in detail the manner in which the well was plugged, indicating where the mud fluid was placed and the method or methods used in introducing it into the hole. If cement or other plugs were used, state the character of same and depth placed, from \_\_\_\_\_ feet to \_\_\_\_\_ feet for each plug set.

Sanded from 3614' to 3270' - dumped 5 sks cement - mudded hole to 250' - set 10' rock bridge - dumped 20 sks of cement - mudded to 30' - set rock bridge - dumped 10 sks of cement to base of cellar.

(If additional description is necessary, use BACK of this sheet)

Name of Plugging Contractor R & D Casing Pulling Company License # 236  
Address Box 569 Ellinwood, Kansas

STATE OF Kansas, COUNTY OF Barton, ss.  
Nathan Meltzer (employee of owner) or (owner or operator) of the above-described well, being first duly sworn on oath, says: That I have knowledge of the facts, statements, and matters herein contained and the log of the above-described well as filed and that the same are true and correct. So help me God.

(Signature)

*Nathan Meltzer*  
Box 191, Great Bend, Kansas  
(Address)

SUBSCRIBED AND SWORN to before me this 5th day of June, 19 59

*Anne Meltzer*  
Anne Meltzer  
Notary Public.

My commission expires 3/30/61

PLUGGING  
FILE SEC. 33 T. 21 R. 12W  
BOOK PAGE 35 LINE 22

6-6-59  
JUN 6 1959  
CONSERVATION DIVISION  
Wichita, Kansas

COPY


WICHITA DIVISION KANSAS GEOLOGICAL SOCIETY  
 112 Union National Bldg. Wichita, Kansas

Company: ARTHELL CO.  
 farm: Bittner No. 2

SEC. 33 T. 21 R. 12 W  
 SE NE NE

Total Depth. 3596'  
 Comm. 10-20-45 Comp. 11-1-45  
 Strat. or Tested.  
 Contractor: Sterling Drilg. Co.  
 issued 6-22-46

County. Stafford  
 KANSAS

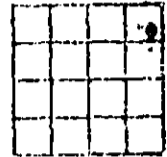

CASING:

10 3/4" 280'  
 7" 3278'  
 5 1/2" 3592' 00' Liner

Elevation. ....

Production. Approx. 100 BO,  
 16 BW on Pump.

Indices Indicate Bottom of Formation.

- sand & shale 0-283
- red bed 185
- shale 650
- anhydrite 670
- shale 1340
- shale & lime 1510
- lime 1600
- lime & shale 1770
- lime brkn 2020
- lime 2070
- shale & shells 2125
- shale & lime 2270
- shale & shells 2360
- shale & lime 2435
- shale 2505
- shale & shells 2565
- shale & lime 2720
- shale & shells 2860
- lime 3180
- shale 3255
- shale & lime 3266
- K. G. Lime 3277
- lime 3387 ?
- shale 3400
- lime 3418
- shale 3422
- lime 3450
- lime (some live oil) 3436
- lime 3470
- some por. & traces of live oil stain 3470-72'
- lime 3490
- lime red, shale, green & chert 3510
- chert 3512
- shale red green & sdy shale 3576
- shale green, oil stain 3592
- dolomite 3596
- Total Depth.

- Tops:
- Conglomerate 3490
- Viola 3510
- Simpson 3542
- Arbuckle 3592

RECEIVED  
 STATE CORPORATION COMMISSION  
 MAY 5 1959  
 CONSERVATION DIVISION  
 Wichita, Kansas

PLUGGING  
 FILE SEC. 33 T. 21 R. 12 W  
 BOOK PAGE 35 LINE 22