


STATE OF KANSAS  
STATE CORPORATION COMMISSION

WELL PLUGGING RECORD

Give All Information Completely  
Make Required Affidavit  
Mail or Deliver Report to  
Conservation Division  
State Corporation Comm.  
245 North Water  
Wichita, KS 67202

Kiowa County, Sec. 13 Twp. 28S Rge. 16W ~~xxx~~  
Location as "NE/CNW1SW1" or footage from lines  
1980' FNL and 1980' FWL

Lease Owner Texas Oil & Gas Corp.  
Lease Name Rose "E" Well No. 1  
Office Address 200 West Douglas, Wichita, Kansas 67202  
Character of Well (Completed as Oil, Gas or Dry Hole)

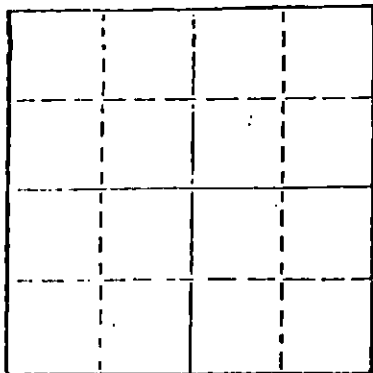

Locate well correctly on above  
Section Plot

Dry Hole  
Date Well completed December 8, 1979  
Application for plugging filed Verbal Application 1979  
Application for plugging approved Verbal Approval 1979  
Plugging commenced December 8, 1979  
Plugging completed December 8, 1979  
Reason for abandonment of well or producing formation

If a producing well is abandoned, date of last production  
1979

Was permission obtained from the Conservation Division or  
its agents before plugging was commenced? Yes

Name of Conservation Agent who supervised plugging of this well Wm. T. Owen  
Producing formation \_\_\_\_\_ Depth to top \_\_\_\_\_ Bottom \_\_\_\_\_ Total Depth of Well 4752'  
Show depth and thickness of all water, oil and gas formations.

OIL, GAS OR WATER RECORDS

CASING RECORD

FORMATION	CONTENT	FROM	TO	SIZE	PUT IN	PULLED OUT
				8-5/8"	384'	None

Describe in detail the manner in which the well was plugged, indicating where the mud fluid  
was placed and the method or methods used in introducing it into the hold. If cement or other  
plugs were used, state the character of same and depth placed, from \_\_\_\_\_ feet to  
\_\_\_\_\_ feet for each plug set.

Filled hole with heavy rotary mud from 4752' (rotary total depth) to  
600 ft. Set plug at 600 ft. and cemented with 40 sacks cement. Filled  
hole with heavy rotary mud from 600 ft. to 390 ft. Set plug at 390 ft. and  
cemented with 40 sacks cement. Filled hole with heavy rotary mud from  
390 ft. to 40 ft. Set solid plug at 40 ft. and cemented with 10 sacks  
cement, 5 sacks cement in rat hole.

Plugging operations accomplished utilizing Dowell Div., Dow Chemical Co.  
cementing pump truck through 4 1/2 inch drill pipe.

DEC 17 1979  
CONSERVATION DIVISION  
Wichita, Kansas  
12-17-79

(If additional description is necessary, use BACK of this sheet)


Name of Plugging Contractor Dowell Div., Dow Chemical Co.  
Hwy 281 & Santa Fe, Pratt, Kansas 67124

STATE OF Kansas COUNTY OF Sedgwick, ss.  
Merle Britting, Agent: ~~(Signature of owner)~~

of the above-described well, being first duly sworn on oath, says: That I have knowledge of  
the facts, statements, and matters herein contained and the log of the above-described well  
as filed and that the same are true and correct. So help me God.

(Signature) Merle Britting  
200 No. Main, Wichita, Kansas 67202  
(Address)

SUBSCRIBED AND SWORN TO before me this 14th day of December, 19 79

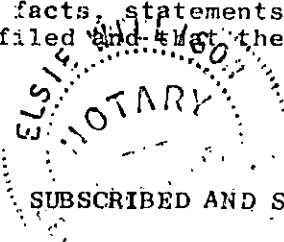

Elsie Willison  
Elsie Willison - Notary Public.

My commission expires July 25, 1982

KANSAS DRILLERS LOG

COMPANY Texas Oil & Gas Corp.

SEC. 13 T. 28S R. 16W

FARM Rose "E" NO. 1

LOC. 1980' FNL &  
1980' FWL

COUNTY Kiowa

ROTARY TOTAL DEPTH 4752'

COMM. November 26, 1979 COMP. December 8, 1979

CONTRACTOR H-30, Inc.

ISSUED December 14, 1979

CASING

10 3/4"

8 5/8" Set at 384' cemented w/400 sxs cement

ELEVATION 2127' K, B,

5 1/2"

4 1/2"

FIGURES INDICATE BOTTOM OF FORMATIONS

Sand and Red Bed	285'
Red Bed	386'
Sand and Shale	1117'
Red Bed and Shale	1910'
Shale and Lime	2233'
Lime and Shale	2400'
Shale and Lime	2785'
Lime and Shale	4752'
Rotary Total Depth	4752'

I hereby certify the above and foregoing to be a true and correct log of the above described well as shown by the drilling reports.

H-30, INC.

*Merle Britting*  
Merle Britting

State of Kansas )  
County of Sedgwick ) ss:

Subscribed and Sworn to before me a Notary Public in and for said county and state this 14th. day of December, 1979.

*Elsie Willison*  
Elsie Willison - Notary Public

My Commission Expires:  
July 25, 1982

