


STATE OF KANSAS
STATE CORPORATION COMMISSION

WELL PLUGGING RECORD

Give All Information Completely
Make Required Affidavit
Mail or Deliver Report to:
Conservation Division
State Corporation Commission
800 Biting Building
Wichita, Kansas

Pawnee County, Sec. 6 Twp. 21 S Rge. 15 (E) 15 (W)

Location as "NE/CNW $\frac{1}{4}$ SW $\frac{1}{4}$ " or footage from lines NW NW SW
Lease Owner Helmerich & Payne, Inc.
Lease Name LEWIS Well No. 1
Office Address 415 Philtower Bldg.
Character of Well (completed as Oil, Gas or Dry Hole) OIL
Date well completed 6-2-49 19
Application for plugging filed 6-18-50 19
Application for plugging approved 6-18-50 19
Plugging commenced 6-6-50 19
Plugging completed 6-16-50 19
Reason for abandonment of well or producing formation Depleted as producer

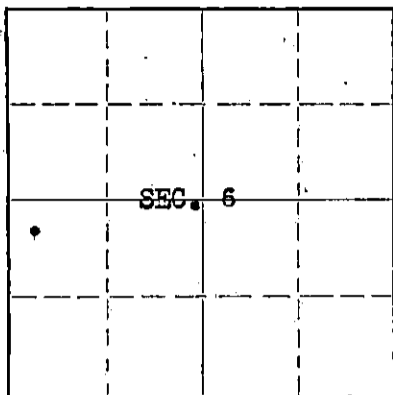

Locate well correctly on above
Section Plat

If a producing well is abandoned, date of last production 4-24-50 19
Was permission obtained from the Conservation Division or its agents before plugging was commenced? Yes

Name of Conservation Agent who supervised plugging of this well C.D. Stough
Producing formation Arbuckle Depth to top 3751 Bottom 3802 Total Depth of Well 3803 Feet
Show depth and thickness of all water, oil and gas formations.

OIL, GAS OR WATER RECORDS

CASING RECORD

Formation	Content	From	To	Size	Put In	Pulled Out
Arbuckle	Oil	3780	3788	8-5/8"	980	none
				5-1/2"	3802	3145

Describe in detail the manner in which the well was plugged, indicating where the mud fluid was placed and the method or methods used in introducing it into the hole. If cement or other plugs were used, state the character of same and depth placed, from.....feet to.....feet for each plug set.

Filled hole to 3740' with chat. Dumped 5 sacks of cement with bailer.

Shot pipe off and pulled 3145' out of hole.

Filled hole with heavy mud. Pumped 100 sacks of cement behind A plug with Halliburton pump truck. Ran bailed found top of cement at 75'. Mudded hole to 15' and dumped 5 sacks of cement, cementing top.

JUL 18 1950

STATE CORPORATION COMMISSION
PLUGGING DIVISION

Correspondence regarding this well should be addressed to Helmerich & Payne, Inc.
Address 415 Philtower Bldg. Tulsa 3, Oklahoma.

STATE OF Oklahoma, COUNTY OF Tulsa, ss.
Harry Saye (employee of owner) or (owner or operator) of the above-described well, being first duly sworn on oath, says: That I have knowledge of the facts, statements, and matters herein contained and the log of the above-described well as filed and that the same are true and correct. So help me God.

(Signature) Harry Saye Prod. Supt.
415 Philtower Bldg. Tulsa 3, Oklahoma
(Address)

SUBSCRIBED AND SWORN TO before me this 17th day of July 1950

My Commission Expires Aug. 29, 1951

My commission expires.....

PLUGGING
FILE SEC 6 21 R 15W
BOOK PAGE 11 LINE 28

Notary Public.

Lewis No. 1
 NW/4 SW/4 Section 6-218-15W
 Pawnee County, Kansas
 White Eagle Oil Company

15.145.01287.0000

Commenced: 5-12-49
 Completed: 5-26-49

Sand, gravel and red bed	0	130
Shale, sand	130	390
Sand, Dakota	390	460
Sand	460	525
Red bed	525	720
Red bed, sand	720	977
Anhydrite	977	980
Lime, anhydrite	980	1000
Shale, shells	1000	1380
Shale, shells	1380	1720
Lime, shale	1720	2160
Lime	2160	2275
Lime, shale	2275	2360
Sand, shale	2360	2385
Shale, lime	2385	2540
Sandy shale and lime	2540	2825
Shale, lime	2825	3305
Shale	3305	3320
Shale and lime	3320	3468
Shale	3468	3485
Lime, soft	3485	3524
Shale	3524	3525
Shale, lime	3525	3695
Lime, dolomite and shale	3695	3730
Shale, lime	3730	3763
Lime	3763	3770
Lime, shale	3770	3803
TOTAL DEPTH	3803	

CASING RECORD

Ran 31 jts of 8 5/8" casing @ 983 with
 500 sacks
 Ran 123 jts of 5 1/2" casing @ 3802 1/2 with
 125 sacks

STATE OF OKLAHOMA)
)
 COUNTY OF TULSA)

I hereby affirm that the above and foregoing is a true and correct copy of the log of our Lewis No. 1 well, located in the Southwest Quarter of the Southwest Quarter of Section 6, Township 21 South, Range 15 West, Pawnee County, Kansas.

HELMESVICH & PAYNE, INC.

By *William Helm*
 Treasurer

Subscribed and sworn to before me, a Notary Public, this 10th day of June, 1949.

W. B. [Signature]
 Notary Public

My Commission expires March 13, 1950.

NOTARY PUBLIC
 JUL 2 1950

PLUGGING
 FILE SECT. 21 R. 15a
 BOOK PAGE 11 LINE 28