


WELL PLUGGING RECORD

Give All Information Completely
Make Required Affidavit
Mail or Deliver Report to:
Conservation Division
State Corporation Commission
800-Altling Building
Wichita, Kansas

NORTH

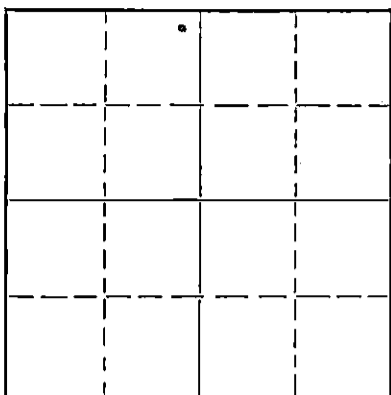

Locate well correctly on above
Section Plat

Pawnee County. Sec. 6 Twp. 21S Rge. 15 (W)
Location as "NE/CNW $\frac{1}{4}$ SW $\frac{1}{4}$ " or footage from lines NE NE NW
Lease Owner Gulf Oil Corporation
Lease Name M. N. Gross Well No. 2
Office Address Box 661, Tulsa, Oklahoma
Character of Well (completed as Oil, Gas or Dry Hole) Oil
Date well completed October 26 19 47
Application for plugging filed August 10 19 50
Application for plugging approved August 14 19 50
Plugging commenced August 18 19 50
Plugging completed August 24 19 50
Reason for abandonment of well or producing formation Well was no longer
economical to operate
If a producing well is abandoned, date of last production August 13 19 50
Was permission obtained from the Conservation Division or its agents before plugging was com-
menced? Yes

Name of Conservation Agent who supervised plugging of this well Mr. C. D. Stough
Producing formation Arbuckle Depth to top 3770' Bottom 3814' Total Depth of Well 3814' Feet
Show depth and thickness of all water, oil and gas formations.

OIL, GAS OR WATER RECORDS

CASING RECORD

Formation	Content	From	To	Size	Put In	Pulled Out
				<u>5 1/2"</u>	<u>3810'</u>	<u>3037'</u>

Describe in detail the manner in which the well was plugged, indicating where the mud fluid was placed and the method or methods used in introducing it into the hole. If cement or other plugs were used, state the character of same and depth placed, from _____ feet to _____ feet for each plug set.

Plugged with 5 sacks of cement from TD to 3803'. Mudded hole from 3803' to 250', dumped 15 sacks of cement, mudded hole to 30' and capped with 10 sacks of cement.

(If additional description is necessary, use BACK of this sheet)

Correspondence regarding this well should be addressed to Mr. S. G. Sanderson
Address Box 661, Tulsa, Oklahoma

SFP 2 X 1950
9-2-1950
KANSAS

STATE OF Kansas, COUNTY OF Rice, ss.

H. H. Wright (employee of owner) or (owner or operator) of the above-described well, being first duly sworn on oath, says: That I have knowledge of the facts, statements, and matters herein contained and the log of the above-described well as filed and that the same are true and correct. So help me God.


(Signature)

Box 544, Chase, Kansas
(Address)

SUBSCRIBED AND SWORN to before me this 29th day of August, 19 50

My commission expires April 14, 1952

22-7377-3 4-40-10M

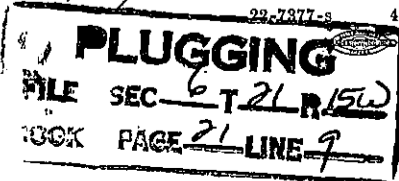

Notary Public.

