


WELL PLUGGING RECORD

Give All Information Completely
Make Required Affidavit
Mail or Deliver Report to:
Conservation Division
State Corporation Commission
211 No. Broadway
Wichita, Kansas

NORTH

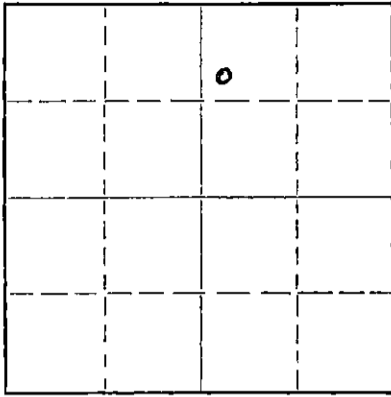

Locate well correctly on above
Section Plat

Stafford County. Sec. 17 Twp. 21 Rge. 11 (E) W (W)
Location as "NE/CNW/SW" or footage from lines SW NE NE
Lease Owner Leo G. Wetherill, Jr.
Lease Name SMITH ESTATE Well No. 17
Office Address 2208 Power & Light Building, KC 5, Mo.
Character of Well (completed as Oil, Gas or Dry Hole) Dry Hole
Date well completed September 26 1963
Application for plugging filed September 26 1963
Application for plugging approved 19
Plugging commenced September 26 1963
Plugging completed September 26 1963
Reason for abandonment of well or producing formation dry hole

If a producing well is abandoned, date of last production 19
Was permission obtained from the Conservation Division or its agents before plugging was commenced? yes

Name of Conservation Agent who supervised plugging of this well Mr. Archie Elving
Producing formation _____ Depth to top _____ Bottom _____ Total Depth of Well 3475 Feet
Show depth and thickness of all water, oil and gas formations.

OIL, GAS OR WATER RECORDS

CASING RECORD

FORMATION	CONTENT	FROM	TO	SIZE	PUT IN	PULLED OUT

Describe in detail the manner in which the well was plugged, indicating where the mud fluid was placed and the method or methods used in introducing it into the hole. If cement or other plugs were used, state the character of same and depth placed, from _____ feet to _____ feet for each plug set.

Filled hole with heavy mud to 290'; Set plug 1/4 sack hulls placed 20 sacks cement through drill pipe on plug.
Filled hole to 40'; set plug, 1/4 sack hulls and 10 sacks cement. Plugged rat hole with 2 sacks cement.

RECEIVED
STATE CORPORATION COMMISSION

SEP 30 1963

CONSERVATION DIVISION
Wichita, Kansas

9-30-63

(If additional description is necessary, use BACK of this sheet)
Name of Plugging Contractor Duke Drlg. Co.
Address Gt. Bend, Ks.

STATE OF KANSAS COUNTY OF BARTON, ss.
L. O. Chubb (employee of owner) or (owner or operator) of the above-described well, being first duly sworn on oath, says: That I have knowledge of the facts, statements, and matters herein contained and the log of the above-described well as filed and that the same are true and correct. So help me God.

(Signature) [Signature]
P.O. Box 823, Great Bend, Kansas
(Address)

SUBSCRIBED AND SWORN TO before me this 27th day of September, 1963

[Signature]
Clair E. Stimson
Notary Public.

My commission expires June 24, 1967



W E L L L O G

Date Commenced: September 18, 1963
Date Completed: September 26, 1963

Leo G. Wetherill, Jr.
SMITH ESTATE #17
SW NE NE Sec. 17-21-11w
Stafford County, Kansas

0	-	50	Surface Sand
50	-	70	Sand and Clay
90	-	525	Red Bed
525	-	558	ANHYDRITE
558	-	1580	Shale & Shells
1580	-	1805	Shale & Lime
1805	-	2070	Lime - Shale
2070	-	2640	Shale & Lime
2640	-	2775	Lime & Shale
2775	-	2994	Lime & Shale
2994	-	2999	Shale - HEEBNER
2999	-	3015	Lime Shale
3015	-	3025	Lime
3025	-	3122	Shale
3122	-	3137	Shale & Lime
3137	-	3379	Lime
3379	-	3399	Chert & Shale
3399	-	3454	Chert - Red Shale
3454	-	3475	Red Shale & Chert RTD

ELEVATION: 1779 K.B.

FORMATION DATA:

ANHYDRITE	525-558
HEEBNER	2994
TORONTO	3015
DOUGLAS	3025
IATAN	3122
LANSING	3137
CONGLOMERATE	3379
VIOLA	3401
R.T.D.	3475

SURFACE CASING: Set 302' of
8-5/8" Casing @ 299' with 200
sacks cement.

AFFIDAVIT


STATE OF KANSAS
COUNTY OF BARTON SS.

I, L. O. Chubb of lawful age, do swear that the facts and statements herein contained are true and correct to the best of his knowledge.



L. O. Chubb

Subscribed and sworn to before me this 27th day of September, 1963.

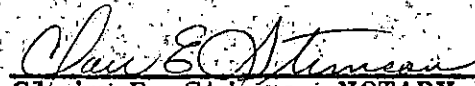

Clair E. Stinson-NOTARY PUBLIC

My Commission Expires:
June 24, 1967

RECEIVED
STATE CORPORATION COMMISSION

SEP 30 1963

CONSERVATION DIVISION
Wichita, Kansas