

STATE OF KANSAS
STATE CORPORATION COMMISSION

Form CP-4

Give All Information Completely
Make Required Affidavit
Mail or Deliver Report to:
Conservation Division
State Corporation Commission
212 No. Market
Wichita, Kansas

WELL PLUGGING RECORD

Stafford County. Sec. 17 Twp. 21 Rge. 11 West (E) (W)

Location as "NE/CNW/SW" or footage from lines NW SE NW

Lease Owner F. G. Holl

Lease Name KEELER Well No. 2

Office Address 6427 East Kellogg

Character of Well (completed as Oil, Gas or Dry Hole) Dry Hole

Date well completed May 9 19 69

Application for plugging filed May 9 19 69

Application for plugging approved May 9 19 69


Plugging commenced May 9 19 69

Plugging completed May 9 19 69

Reason for abandonment of well or producing formation

If a producing well is abandoned, date of last production 19

Was permission obtained from the Conservation Division or its agents before plugging was commenced? Yes

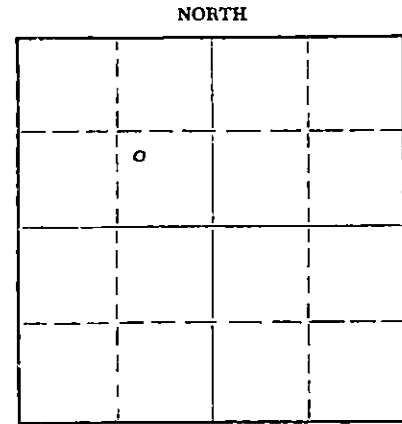

Locate well correctly on above Section Plat

Name of Conservation Agent who supervised plugging of this well Ralph Warren

Producing formation Depth to top Bottom Total Depth of Well 3495 Feet

Show depth and thickness of all water, oil and gas formations.

OIL, GAS OR WATER RECORDS

CASING RECORD

FORMATION	CONTENT	FROM	TO	SIZE	PUT IN	PULLED OUT

STATE CORPORATION COMMISSION
RECEIVED
MAY 1 7 1969
CONSERVATION DIVISION
Wichita, Kansas
5-13-69

Describe in detail the manner in which the well was plugged, indicating where the mud fluid was placed and the method or methods used in introducing it into the hole. If cement or other plugs were used, state the character of same and depth placed, from feet to feet for each plug set.

Hole full with heavy mud to 450
Set plug, pumped 50 sacks cement thru drill pipe
Come up hole to 250' - 25 sacks cement pumped thru d.p. (plug)
Come up to 40' - plug - good bridge - 10 sacks cement
2 sacks cement in rat hole

(If additional description is necessary, use BACK of this sheet)

Name of Plugging Contractor
Address

STATE OF KANSAS, COUNTY OF BARTON, ss.

Larry Curtis (employee of owner) or (owner or operator) of the above-described well, being first duly sworn on oath, says: That I have knowledge of the facts, statements, and matters herein contained and the log of the above-described well as filed and that the same are true and correct. So help me God.

(Signature) Larry Curtis
Box 823 - Great Bend, Ks.
(Address)

SUBSCRIBED AND SWORN to before me this 10 day of May, 19 69

My commission expires April 11, 1970

Marathy M. Hague
Notary Public.

W E L L L O G

DATE COMMENCED: May 2, 1969
DATE COMPLETED: May 9, 1969

F. G. Holl
KEELER #2
NW SE NW
Sec. 17-21-11w
Stafford County, Kansas

ELEVATION 1781 K.B.

0 - 165' Sand & Clay
165 - 541' Red Bed
541 - 562' Anhydrite
562 - 1345' Shale & Shells
1345 - 1685' Shale & Lime
1685 - 2145' Lime & Shale
2145 - 2425' Shale
2425 - 2940' Shale & Lime
2940 - 3005' Lime
3005 - 3009' Heebner- Shale
3009 - 3029' Lime & Shale
3029 - 3037' Lime
3037 - 3132' Shale
3132 - 3150' Lime - Shale
3150 - 3404' Lime
3404 - 3411' Shale
3411 - 3429' Conglomerate
3429 - 3444' Chert
3444 - 3446' Shale
3446 - 3457' Sand
3457 - 3477' Conglomerate
3477 - 3495' Dolomite

FORMATION DATA

Anhydrite 541
Heebner 3005
Toronto 3029
Douglas 3037
Brown Lime 3132
Lansing 3150
Base K.C. 3404
Congl. 3411
Viola Chert 3429
Simp. Shale 3444
Simp. Sand 3446
Arbuckle 3477
RTD 3495

SURFACE PIPE: Set new
8-5/8" 20# at 250' with
225 sacks cement.

A F F I D A V I T

STATE OF KANSAS
COUNTY OF BARTON) ss.

Larry Curtis, of lawful age, does swear that the facts and statements herein contained are true and correct to the best of his knowledge.

Subscribed and sworn to before me this 10 day of May, 1969.

My Comm. Expires:
April 11, 1970

Maechig M. Hagan
Notary Public

RECEIVED
STATE CORPORATION COMMISSION
MAY 13 1969
CONSERVATION DIVISION
Wichita, Kansas