

WELL PLUGGING RECORD


STATE OF KANSAS
STATE CORPORATION COMMISSION

Give All Information Completely
Make Required Affidavit
Mail or Deliver Report to:
Conservation Division
State Corporation Commission
800 Bifling Building
Wichita, Kansas

FORMATION PLUGGING RECORD

Strike out upper line
when reporting plug-
ging off formations.

Stafford County. Sec. 17 Twp 21 Rge. (E) 11 (W)
Location as "NE 1/4 NW 1/4 SW 1/4" or footage from lines NWC NE 1/4
Lease Owner D. R. Lauck
Lease Name Smith Well No. 1
Office Address Wichita Kansas
Character of Well (completed as Oil, Gas or Dry Hole) dry hole
Date well completed April 4, 19 49
Application for plugging filed April 4, 19 49
Application for plugging approved April 4, 19 49
Plugging commenced April 4, 19 49
Plugging completed April 4, 19 49
Reason for abandonment of well or producing formation

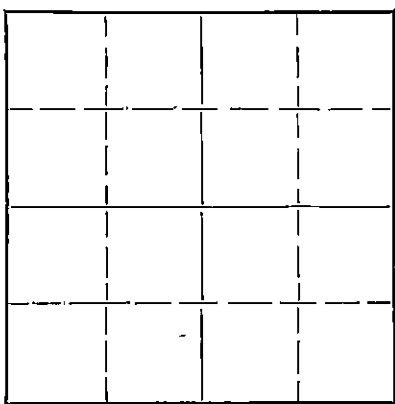

Locate well correctly on above
Section Plat

Name of Conservation Agent who supervised plugging of this well Stough
Producing formation none Depth to top Bottom Total Depth of Well 3471 Feet
Show depth and thickness of all water, oil and gas formations.

OIL, GAS OR WATER RECORDS

CASING RECORD

Formation	Content	From	To	Size	Put In	Pulled Out
Arbuckle lime	water	3456	3471			

Describe in detail the manner in which the well was plugged, indicating where the mud fluid was placed and the method or methods used in introducing it into the hole. If cement or other plugs were used, state the character of same and depth placed, from feet to feet for each plug set.

mud 3471 - 250'
plug 250 245
cement 245 210
mud 210 31
plug 31 26
cement 26 6

REC'D
APR 9 1949
ST. LOUIS
MO.
KANSAS
4-9-49

(If additional description is necessary, use BACK of this sheet)

Correspondence regarding this well should be addressed to D. R. Lauck
Address Wichita, Kansas

STATE OF Kansas, COUNTY OF Sedgwick, ss.
P. R. Bishop (employee of owner)


being first duly sworn on oath, says: That I have knowledge of the facts, statements, and matters herein contained and the log of the above-described well as filed and that the same are true and correct. So help me God.

(Signature) P. R. Bishop
Wichita Kansas
(Address)

SUBSCRIBED AND SWORN to before me this 7th day of April, 19 49

Elizabeth Ray
Notary Public

My commission expires Sept. 14, 1951

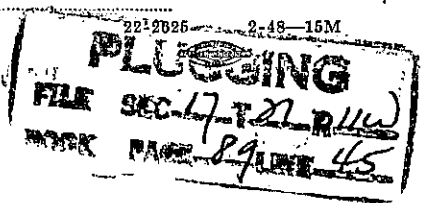

D. R. LAUCKSmith #1Sec. 17ⁿ Twp. 21S. R11WNWc NE $\frac{1}{4}$

Stafford County Kansas

Commenced March 23, 1949

Completed Apr. 4, 1949

Casing:

10" 251' cemented 275 sacks

sand	190
red rock	590
Anhydrite	615
Shale & shells	1465
Broken lime	1605
shale & lime	2800
Lime	2910
Lime & shale	3155
Lime	3395
Conglomerate	3405
Chert	3418
Lime	3473

Tops - Derrick Floor

Heebner	3005
Brown lime	3130
white lime	3155
white chert	3394
red rock chert	3418
shale	3437
Arbuckle	3456
Total Depth	3471

