

STATE OF KANSAS
STATE CORPORATION COMMISSION

WELL PLUGGING RECORD

Give All Information Completely
Make Required Affidavit
Mail or Deliver Report to:
Conservation Division
State Corporation Commission
800 Bittling Building
Wichita, Kansas

stafford County, Sec. 17 Twp. 21s Rge. 11 (E) 11 (W)

Location as "NE/CNW/4SW 1/4" or footage from lines Center 1/2 - SE 1/4 - NE 1/4

Lease Owner Champlin Refining Company

Lease Name Smith "A"

Office Address P.O. Drawer #552, Enid, Oklahoma. Well No. 2

Character of Well (completed as Oil, Gas or Dry Hole) Oil

Date well completed Nov. 1, 19 40

Application for plugging filed March 9, 19 49

Application for plugging approved March 11, 19 49


Plugging commenced March 22, 19 49

Plugging completed March 25, 19 49

Reason for abandonment of well or producing formation Well producing 100% Water

If a producing well is abandoned, date of last production February 18, 19 49

Was permission obtained from the Conservation Division or its agents before plugging was commenced? Yes

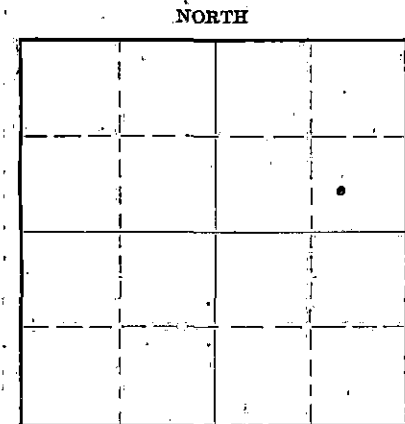

Locate well correctly on above Section Flat

Name of Conservation Agent who supervised plugging of this well C. D. Stough, Great Bend, Kansas.

Producing formation Depth to top Bottom Total Depth of Well 3425 Feet

Show depth and thickness of all water, oil and gas formations.

OIL, GAS OR WATER RECORDS

CASING RECORD

| Formation | Content | From | To | Size | Put In | Pulled Out |
|-----------|---------|------|----|-----------|--------|------------|
| | | | | 8 5/8" OD | 365' | None |
| | | | | 4 1/2" OD | 3389' | 2580' |
| | | | | | | |
| | | | | | | |
| | | | | | | |
| | | | | | | |
| | | | | | | |
| | | | | | | |
| | | | | | | |
| | | | | | | |

Describe in detail the manner in which the well was plugged, indicating where the mud fluid was placed and the method or methods used in introducing it into the hole. If cement or other plugs were used, state the character of same and depth placed, from feet to feet for each plug set.

Set cement plug in bottom at 3425' TD using 4 sacks of cement then filled hole with heavy mud from top of plug to 350' and set rock bridge and cement plug using 15 sacks of cement then filled hole with heavy mud from top of plug to 40' and set cement plug from 40' to bottom of cellar using 10 sacks of cement.

RECEIVED

MAR 29 1949 3-29-49

STATE CORPORATION COMMISSION KANSAS

(If additional description is necessary, use BACK of this sheet)

Correspondence regarding this well should be addressed to Champlin Refining Company, P. O. Drawer #552, Enid, Oklahoma.

STATE OF Kansas COUNTY OF Barton ss. S. P. Hall

(employee of owner) or (owner or operator) of the above-described well, being first duly sworn on oath, says: That I have knowledge of the facts, statements, and matters herein contained and the log of the above-described well as filed and that the same are true and correct. So help me God.

(Signature) S. P. Hall

P. O. Box 167, Ellinwood, Kansas.


(Address) 49

SUBSCRIBED AND SWORN TO before me this 28th day of March, 19 49

N. Kenneth Steiner

Notary Public.

My commission expires October 24, 1951

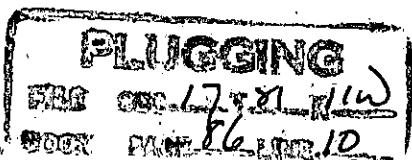

CHAMPLIN REFINING COMPANY

SMITH A #2 WELL

660' from South Ln. & 990' from East Line of the
NE $\frac{1}{4}$ of Section 17 - 21S - 11W Stafford County, Kans.FORMATION LOG

| | | | |
|-------|---|-------|-----------------------|
| 0' | - | 250' | Sand & gravel |
| 250' | - | 340' | Sand & gravel |
| 340' | - | 365' | Red Bed |
| 365' | - | 520' | Red bed |
| 520' | - | 550' | Anhydrite |
| 550' | - | 565' | Shale |
| 565' | - | 1265' | Red Bed, Shale & Salt |
| 1265' | - | 1530' | Shale & Shells |
| 1530' | - | 1710' | Shale & Lime |
| 1710' | - | 1740' | Sand |
| 1740' | - | 1840' | Lime |
| 1840' | - | 2040' | Shale & lime |
| 2040' | - | 2190' | Shale & Shells |
| 2190' | - | 2350' | Shale |
| 2350' | - | 2465' | Shale & Lime |
| 2465' | - | 2565' | Lime & Shale |
| 2565' | - | 2700' | Lime |
| 2700' | - | 2800' | Lime |
| 2800' | - | 2830' | Lime |
| 2830' | - | 2865' | Lime & Shale |
| 2865' | - | 2915' | Lime & Shale |
| 2915' | - | 3000' | Lime |
| 3000' | - | 3100' | Lime |
| 3100' | - | 3145' | Lime |
| 3145' | - | 3250' | Lime |
| 3250' | - | 3325' | Lime & Shale |
| 3325' | - | 3380' | Lime & Shale |
| 3380' | - | 3402' | Lime & Shale |
| 3402' | - | 3420' | Lime & Shale |
| 3420' | - | 3425' | Lime & Shale |
| 3425' | | | Total Depth |

RECEIVED

Conservation Div.

MAR 10 1949

STATE CORPORATION
COMMISSION
KANSASCOTTON FIBRE
ENGLISH BRAND

Fox River

PLUGGINGFILE SEC 17 T 21 R 11 W
BOOK PAGE 86 LINE 10