


Give All Information Completely
Make Required Affidavit
Mail or Deliver Report to:
Conservation Division
State Corporation Commission
800 Bittig Building
Wichita, Kansas

WELL PLUGGING RECORD

15-009-00552-00-00

NORTH

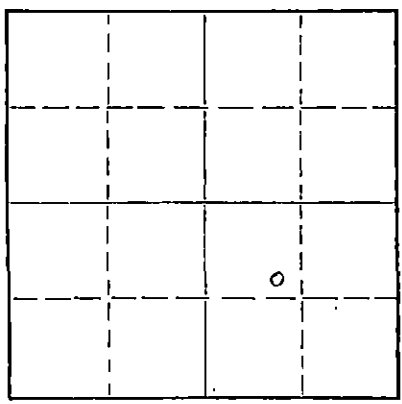

Locate well correctly on above Section Plat

Barton County. Sec. 28 Twp. 16 Rge. 12 (E) W (W)
Location as "NE/CNW/SW" or footage from lines SE NW SE
Lease Owner Harms-Burt Drilling Company
Lease Name Hitschman Well No. #1
Office Address Box 184, Great Bend, Kansas
Character of Well (completed as Oil, Gas or Dry Hole) Dry Hole
Date well completed September 2, 1955
Application for plugging filed " " 1955
Application for plugging approved " " (orally) 1955
Plugging commenced " " 1955
Plugging completed " " 1955
Reason for abandonment of well or producing formation Dry Hole

If a producing well is abandoned, date of last production _____ 19____
Was permission obtained from the Conservation Division or its agents before plugging was commenced? Yes

Name of Conservation Agent who supervised plugging of this well Warren H. Horner, Box 207, Great Bend, Ks.
Producing formation _____ Depth to top _____ Bottom _____ Total Depth of Well 3400 Feet
Show depth and thickness of all water, oil and gas formations.

OIL, GAS OR WATER RECORDS

CASING RECORD

FORMATION	CONTENT	FROM	TO	SIZE	PUT IN	PULLED OUT
Surface		0	210	8 5/8"	210	None

Describe in detail the manner in which the well was plugged, indicating where the mud fluid was placed and the method or methods used in introducing it into the hole. If cement or other plugs were used, state the character of same and depth placed, from _____ feet to _____ feet for each plug set.

Filled hole with mud from 3400' TD to 200' with plug set at 200' & 20 sacks of cement on top of plug. Heavy mud to 35' with plug set at 35' and 10 sacks of cement on top of plug.

(If additional description is necessary, use BACK of this sheet)

Name of Plugging Contractor Harms-Burt Drilling Company
Address Box 184, Great Bend, Kansas

STATE OF Kansas, COUNTY OF Barton, ss.
Allan Harms (employee of owner) or (owner or operator) of the above-described well, being first duly sworn on oath, says: That I have knowledge of the facts, statements, and matters herein contained and the log of the above-described well as filed and that the same are true and correct. So help me God.

(Signature) Allan Harms
Box 184, Great Bend, Kansas
(Address)

SUBSCRIBED AND SWORN TO before me this 9 day of Nov. 1955

My commission expires 1-20-58

Mary E Van Pelt
Notary Public.

STATE OF KANSAS
11-10-55

PLUGGING
FILE SEC 28 T. 16 R. 12 W
BOOK PAGE 47 LINE 25

DRILLERS LOG

Company: Harms-Burt Drilling Co.

Farm: Hirschman #1 - SE NW SE Sec. 28-16-12W - Barton County, Kansas

Commenced: August 25, 1955

Completed: September 2, 1955

Elevation: 1906 RB

0 - 20	soil & clay
20 - 40	lime
40 - 210	shale
210 - 350	shale & shells
350 - 420	sand
420 - 500	shale & shells
500 - 630	Red Bed
630 - 810	Red Bed & shale
810 - 835	Anhydrite
835 - 1440	shale & shells
1440 - 1535	lime & shale
1535 - 1630	lime
1630 - 2130	lime & shale
2130 - 2185	lime
2185 - 2225	lime & shale
2225 - 2550	shale & lime
2550 - 2750	lime & shale
2750 - 2785	lime
2785 - 2895	lime & shale
2895 - 3033	lime
3022 - 3098	lime & shale
3098 - 3385	lime
3385 - 3400	Arbuckle lime
3400 -	TD

Set 210' of 8 5/8" surface pipe. Cemented with 125 sacks of common cement & 2 sacks of caldum chloride.

Tops:	Anhydrite	810
	Heebner	3010
	Brown Lime	3098
	Lansing-K.C.	3114
	Arbuckle	3385

Drill stem tests: #1 3277-3315 - open 30 min.-shut in 20 min. Recovered 3 feet of mud. IFP O# FFP O# BHP 90#

Dry, Plugged & Anandoned.

AFFIDAVIT:

State of Kansas)
 SS
 County of Barton)

I, Allan Harms, of Harms-Burt Drilling Company, being first duly sworn on oath state: I have knowledge of the facts, statements, and matters herein contained and the same are true and correct. *Allan Harms*

Subscribed and sworn to before me this 9 day of Nov. 1955.

Mary E Van Pelt
 Notary Public

My commission expires 1-20-58.

PLUGGING
 SEC 28-16-12W
 PAGE 42 LINE 25