


STATE OF KANSAS
STATE CORPORATION COMMISSION

Form CP-4

Give All Information Completely
Make Required Affidavit
Mail or Deliver Report to:
Conservation Division
State Corporation Commission
212 No. Market
Wichita, Kansas

WELL PLUGGING RECORD

NORTH

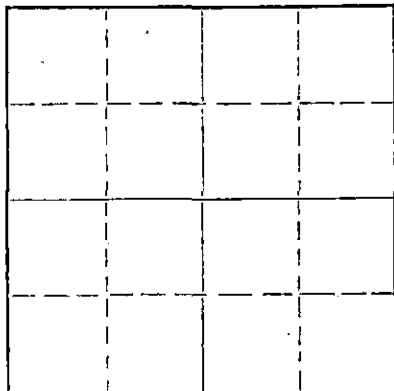

Locate well correctly on above
Section Plat

Barton County. Sec. 28 Twp. 16 Rge. 12 (E) (W)
Location as "NE/CNW/SW" or footage from lines NE NW NE
Lease Owner Duke Drilling Company
Lease Name Hitschmann Well No. 1
Office Address P. O. Box 823 Great Bend, Kansas
Character of Well (completed as Oil, Gas or Dry Hole) _____
Date well completed _____ 19____
Application for plugging filed 1-1-67 19____
Application for plugging approved 1-5-67 19____
Plugging commenced 1-9-67 19____
Plugging completed 1-29-67 19____
Reason for abandonment of well or producing formation _____

If a producing well is abandoned, date of last production _____ 19____
Was permission obtained from the Conservation Division or its agents before plugging was commenced? Yes

Name of Conservation Agent who supervised plugging of this well Donald Truan
Producing formation _____ Depth to top _____ Bottom _____ Total Depth of Well 3399 Feet
Show depth and thickness of all water, oil and gas formations.

OIL, GAS OR WATER RECORDS

CASING RECORD

FORMATION	CONTENT	FROM	TO	SIZE	PUT IN	PULLED OUT
				8 5/8	310	None
				5 1/2	None	2541

RECEIVED
STATE CORPORATION COMMISSION
2-1-67
FEB 1 1967

Describe in detail the manner in which the well was plugged, indicating where the mud fluid was placed and the method or methods used in introducing it into the hole. If cement or other plugs were used, state the character of same and depth placed, from _____ feet to _____ feet for each plug set.

Moved in. Cleaned out cellar. Cut off poor boy head.

Sanded to 3350'. Dumped 5 sacks of cement. Working pipe. Shot pipe at 2685'.

Circulating. Spotted 70 bbl. of oil. Working pipe.

Working pipe.

Working pipe. Shot pipe at 2600' and 2530'. Pulling pipe.

Pulling pipe. Plugging well. Build rock bridge at 300'. Dumped 25 sacks of cement. Filled hole and rock bridge. Capped well with 10 sacks of cement.

(If additional description is necessary, use BACK of this sheet)

Name of Plugging Contractor Forbes Casing Pulling, Inc.
Address P. O. Box 221 Great Bend, Kansas

STATE OF Kansas, COUNTY OF Barton, ss.
J. O. Forbes (employee of owner) or (owner or operator) of the above-described well, being first duly sworn on oath, says: That I have knowledge of the facts, statements, and matters herein contained and the log of the above-described well as filed and that the same are true and correct. So help me God.

(Signature) J O Forbes
P. O. Box 221 Great Bend, Kansas
(Address)

SUBSCRIBED AND SWORN TO before me this 31 day of January 1967

My commission expires May 27, 1969

Notary Public.

WELL LOG

Date Started: 6-18-57
Date Completed: 6-27-57

Hitschmann No. 1
NE NW NE
Section 28-16-12
Barton County, Kansas

15-009-07403-00-00

Elevation	1918' K.B.
Anhydrite	811' (-1107)
Heebner	2994' (-1076)
Toronto	3011' (-1093)
Douglas	3023' (-1105)
Iston	3082' (-1164)
Lensing	3101' (-1183)
Conglomerate	3346' (-1428)
Arbuckle	3364' (-1446)
R.T.D.	3368' (-1450)

0' - 30'	Surface Clay
30' - 40'	Clay and Rock
40' - 85'	Shale
85' - 90'	Sand
90' - 100'	Shale
100' - 180'	Sand
180' - 260'	Shale and Sand
260' - 280'	Sand
280' - 420'	Shale and Clay
420' - 470'	Dakota
470' - 572'	Dakota and Shale
572' - 811'	Red Bed
811' - 838'	Anhydrite
838' - 843'	Shale and Shells
843' - 1175'	Shale and Shells
1175' - 1400'	Salt and Shale
1400' - 1580'	Shale and Shells
1580' - 1650'	Shale, Shell and Lime Streak
1650' - 2005'	Broken Lime
2005' - 2425'	Lime and Shale
2425' - 2712'	Lime and Shale
2712' - 2790'	Lime
2790' - 2994'	Lime
2994' - 3089'	Heebner
3089' - 3101'	Lime
3101' - 3150'	Lensing
3150' - 3278'	Lime
3278' - 3364'	Lime
3364' - 3368'	Arbuckle
3368'	R.T.D.

RECEIVED
OF THE CORPORATION COMMISSION
JAN 5 1967
CONSERVATION DIVISION
Wichita, Kansas

AFFIDAVIT

State of Kansas County of Barton

I, Cecil M. Olson, employee of the owner, do swear that the statements and matter herein contained are true to the best of my knowledge.

THE DUKE DRILLING COMPANY

BY: Cecil M. Olson

Subscribed and sworn before me this 29th day of July, 1957.

John E. Stinson
NOTARY PUBLIC

My commission expires: June 24, 1959.