


STATE OF KANSAS  
STATE CORPORATION COMMISSION

Form CP-4

Give All Information Completely  
Make Required Affidavit  
Mail or Deliver Report to:  
Conservation Division  
State Corporation Commission  
212 No. Market  
Wichita, Kansas

WELL PLUGGING RECORD

NORTH

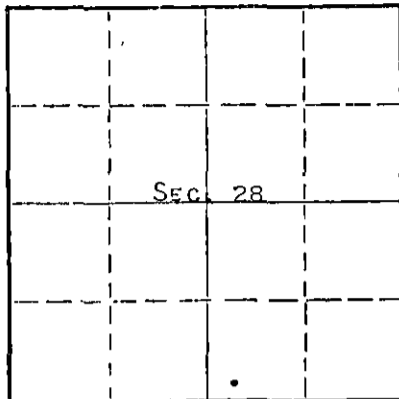

Locate well correctly on above  
Section Plat

BARTON County, Sec. 28 Twp. 16S Rge. 12 (E) (W)  
Location as "NE/CNW/SE" or footage from lines SW SW SE  
Lease Owner PETROLEUM, INC.  
Lease Name HITSCHMANN Well No. B-1  
Office Address R.R. #2, GREAT BEND, KANSAS  
Character of Well (completed as Oil, Gas or Dry Hole) DRY HOLE  
Date well completed MARCH 18 19 68  
Application for plugging filed MARCH 18 19 68  
Application for plugging approved MARCH 18 19 68  
Plugging commenced MARCH 18 19 68  
Plugging completed MARCH 18 19 68  
Reason for abandonment of well or producing formation NO PRODUCIBLE ZONE

If a producing well is abandoned, date of last production NONE 19  
Was permission obtained from the Conservation Division or its agents before plugging was commenced? YES

Name of Conservation Agent who supervised plugging of this well DONALD TRUAN  
Producing formation \_\_\_\_\_ Depth to top \_\_\_\_\_ Bottom \_\_\_\_\_ Total Depth of Well 3386 Feet  
Show depth and thickness of all water, oil and gas formations.

OIL, GAS OR WATER RECORDS

CASING RECORD

FORMATION	CONTENT	FROM	TO	SIZE	PUT IN	PULLED OUT
				8-5/8"	368'	NONE

Describe in detail the manner in which the well was plugged, indicating where the mud fluid was placed and the method or methods used in introducing it into the hole. If cement or other plugs were used, state the character of same and depth placed, from \_\_\_\_\_ feet to \_\_\_\_\_ feet for each plug set.

HEAVY MUD TO 360', FOLLOWED BY WOODEN PLUG, PLACED 1/4 SACK HULLS AND 25 SACKS CEMENT ON TOP OF PLUG. HEAVY MUD TO 40', FOLLOWED BY WOODEN PLUG, PLACED 10 SACKS CEMENT ON TOP OF PLUG TO BASE OF WELL CELLAR.

RECEIVED  
STATE CORPORATION COMMISSION  
MAR 26 1968  
CONSERVATION DIVISION  
Wichita, Kansas

(If additional description is necessary, use BACK of this sheet)  
Name of Plugging Contractor GARVEY DRILLING COMPANY  
Address R.R. #2, GREAT BEND, KANSAS

STATE OF KANSAS, COUNTY OF BARTON, ss.  
MONTE CHADD, DIST. PROD. SUPT. (employee of owner) or (owner or operator) of the above-described well, being first duly sworn on oath, says: That I have knowledge of the facts, statements, and matters herein contained and the log of the above-described well as filed and that the same are true and correct. So help me God. MONTE CHADD, DIST. PROD. SUPT.

(Signature) *Monte Chadd*  
R.R. #2, GREAT BEND, KANSAS (Address)

SUBSCRIBED AND SWORN to before me this 25 day of MARCH, 19 68

My commission expires MAY 28, 1969 *Richard H. Deimler* Notary Public.

15-009-20210-00-00

Q

# WELL LOG

COMPANY Petroleum, Inc.

SEC. 28 T. 16S R. 12W

FARM Hitschmann

NO. B-1

LOC. SW SW SE


TOTAL DEPTH 3386'

COUNTY Barton

COMM. 3-11-68

COMP. 3-18-68

CONTRACTOR Garvey Drilling Company

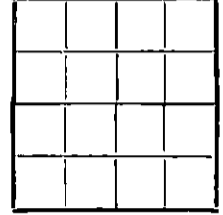

CASING 8 5/8" @ 368' w/185 SX

ELEVATION 1902' DF

PRODUCTION D & A

FIGURES INDICATE BOTTOM OF FORMATIONS

- 60' Post Rock
- 120' Clay
- 369' Blue Shale
- 470' Shale
- 1585' Shale and Shells
- 1720' Shale and Lime
- 1890' Lime and Shale
- 1960' Lime
- 2370' Shale and Lime
- 3095' Lime and Shale
- 3386' Lime
- 3386' RTD

RECEIVED  
 STATE CORPORATION COMMISSION  
 MAR 26 1968  
 CONSERVATION DIVISION  
 Wichita, Kansas

State of Kansas }  
 County of Barton } SS

I, Sam N. Stephens of Garvey Drilling Company  
 upon oath state the above and foregoing is a true and correct copy of the log of the Hitschmann B-1 well.

Sam N. Stephens

Subscribed and sworn to before me this 21st day of March 19 68

My Commission Expires: November 5th, 1969

Richard A. Boyd  
 NOTARY PUBLIC