

CARD MUST BE TYPED

State of Kansas
NOTICE OF INTENTION TO DRILL
(see rules on reverse side)

CARD MUST BE SIGNED

Starting Date: 12 7 84
month day year 4'05

API Number 15- 191-21, 778.0000

OPERATOR: License # 5643
Name Jenkins & Broyles Prod. Co.
Address Route 2 Box 20
City/State/Zip Arkansas City KS 67005
Contact Person Ed Broyles
Phone 316 442 6334

..... NW NE NW ... Sec . . 5 . Twp 33 . S, Rge . . 1. East
(location) West

4950 Ft North from Southeast Corner of Section
3630 Ft West from Southeast Corner of Section
(Note: Locate well on Section Plat on reverse side)

CONTRACTOR: License # 9804
Name B & W Drilling Co.
City/State Box 902 Arkansas City KS 67005

Nearest lease or unit boundary line 330 feet.
County Sumner
Lease Name Ancell Well# 5

Well Drilled For: Well Class: Type Equipment:
 Oil Swd Infield Mud Rotary
 Gas Inj Pool Ext. Air Rotary
 OWWO Expl Wildcat Cable

Domestic well within 330 feet : yes no
Municipal well within one mile : yes no

If OWWO: old well info as follows:

Operator
Well Name
Comp Date Old Total Depth
Projected Total Depth 4100 feet
Projected Formation at TD
Expected Producing Formations

Depth to Bottom of fresh water 60 feet
Lowest usable water formation ... Wellington
Depth to Bottom of usable water 250 feet
Surface pipe by Alternate : 1 2
Surface pipe to be set 250 feet
Conductor pipe if any required feet
Ground surface elevation feet MSL
This Authorization Expires 6-6-85
Approved By 12-6-84 R

I certify that we will comply with K.S.A. 55-101, et seq., plus eventually plugging hole to K.C.C. specifications.

Date 12/6/84 Signature of Operator or Agent

Raquel Robles


Title As agent

MHC/KOHE 12/6/84 Form C-1 4/84

Must be filed with the K.C.C. five (5) days prior to commencing well
 This card void if drilling not started within six (6) months of date received by K.C.C.

Important procedures to follow :

A Regular Section of Land
1 Mile = 5,280 Ft.

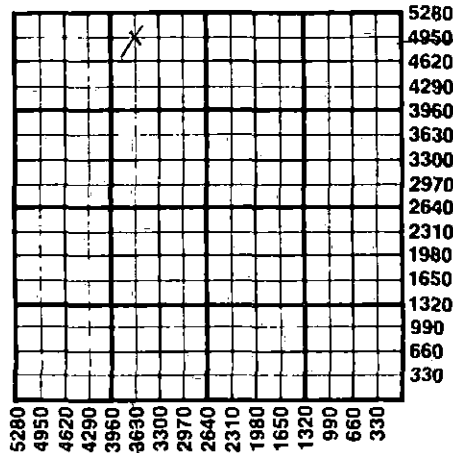

1. Notify District office before setting surface casing.
2. Set surface casing by circulating cement to the top.
3. File completion forms ACO-1 with K.C.C. within 90 days of well completion, following instructions on ACO-1, side 1, and including copies of wireline logs.
4. Notify District office 48 hours prior to old well workover or re-entry.
5. Prior to plugging, prepare a plugging plan, then obtain agreement from the appropriate district office for an approved plugging plan.
6. Submit plugging report (CP-4) to K.C.C. after plugging is completed.
7. Obtain an approved injection docket number before disposing of salt water.
8. Notify K.C.C. within 10 days when injection commences or terminates.
9. If an alternate 2 completion, cement in the production pipe from below any usable water to surface within 120 days of spud date.

RECEIVED
 STATE CORPORATION COMMISSION
 WICHITA, KANSAS
 12-6-84

State Corporation Commission of Kansas
Conservation Division
200 Colorado Derby Building
Wichita, Kansas 67202
(316) 263-3238