

CARD MUST BE TYPED

State of Kansas

CARD MUST BE SIGNED

NOTICE OF INTENTION TO DRILL

(see rules on reverse side)

Expected Spud Date. 12-28-87
month day yearAPI Number 15— 009-24, 284-00-00OPERATOR: License # 5011Name Viking ResourcesAddress 120 S. Market, Suite 518City/State/Zip Wichita, KS 67202-3819Contact Person Jim DevlinPhone (316) 262-2502

CONTRACTOR: License #

Name Unknown

City/State

Well Drilled For: Well Class: Type Equipment:

☒ Oil ☐ Storage ☐ Infield ☒ Mud Rotary☐ Gas ☐ Inj ☒ Pool Ext. ☐ Air Rotary☐ OWWO ☐ Expl ☐ Wildcat ☐ Cable

If OWWO: old well info as follows:

Operator

Well Name

Comp Date Old Total Depth

I certify that well will comply with K.S.A. 55-101, et seq., plus eventually plugging hole to KCC specifications.

Date 3 Decm. 1987 Signature of Operator or Agent James B. Devlin Title Operator

For KCC Use:

Conductor Pipe Required feet; Minimum Surface Pipe Required 360 feet per Alt. OneThis Authorization Expires 6-4-88 Approved By John 12-4-87EFFECTIVE DATE: 12-9-87NW NE NW Sec. 27 Twp. 16 S, Rg. 12 X East4950 Ft. from South Line of Section3630 Ft. from East Line of Section

(Note: Locate well on Section Plat on reverse side)


Nearest lease or unit boundary line 330 feetCounty BartonLease Name Demil Well # 1Ground surface elevation 1900 est. feet MSLDomestic well within 330 feet: ☐ yes ☒ noMunicipal well within one mile: ☐ yes ☒ noDepth to bottom of fresh water 100Depth to bottom of usable water 340Surface pipe by Alternate: 1 X 2Surface pipe planned to be set 360Conductor pipe required NoneProjected Total Depth 3365 feetFormation Arbuckle

Must be filed with the K.C.C. five (5) days prior to commencing well
This card void if drilling not started within six (6) months of date received by K.C.C.

Important procedures to follow:

1. Notify District office before setting surface casing.
2. Set surface casing by circulating cement to the top.
3. File completion forms ACO-1 with K.C.C. within 120 days of well spud date, following instructions on ACO-1, side 1, and including copies of wireline logs.
4. Notify District office 48 hours prior to old well workover or re-entry.
5. Prior to filing Intent, prepare a proposed plugging plan in case well is D & A, then obtain approval of plan when calling district office prior to setting surface pipe.
6. Submit plugging report (CP-4) to K.C.C. after plugging is completed.
7. Obtain an approved injection docket number before disposing of salt water.
8. Notify K.C.C. within 10 days when injection commences or terminates.
9. If an alternate 2 completion, cement in the production pipe from below any usable water to surface within 120 days of spud date.

A Regular Section of Land
1 Mile = 5,280 Ft.

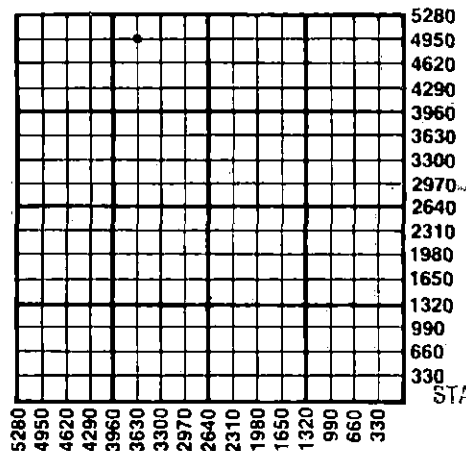

RECEIVED
STATE CORPORATION COMMISSION

DEC 4
12-4-87
CONSERVATION DIVISION
Wichita, Kansas

State Corporation Commission of Kansas
Conservation Division
200 Colorado Derby Building
Wichita, Kansas 67202-1212
(316) 263-3238