


WELL PLUGGING RECORD

Give All Information Completely  
Make Required Affidavit  
Mail or Deliver Report to:  
Conservation Division  
State Corporation Commission  
800 Bitting Building  
Wichita, Kansas

NORTH

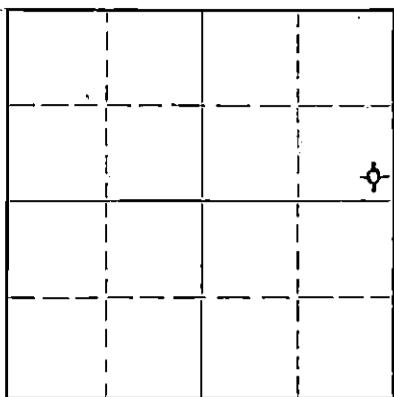

Locate well correctly on above Section Plat

Stafford County. Sec. 28 Twp. 21 Rge. 14 (B) (W)  
Location as "NE/CNW $\frac{1}{4}$ SW $\frac{1}{4}$ " or footage from lines SE. SE. NE  
Lease Owner The Derby Oil Company  
Lease Name Strickler Well No. 1  
Office Address Box 1030, Wichita, Kansas  
Character of Well (completed as Oil, Gas or Dry Hole) Dry Hole  
Date well completed August 17 1950  
Application for plugging filed August 22 1950  
Application for plugging approved 19  
Plugging commenced August 17 1950  
Plugging completed August 17 1950  
Reason for abandonment of well or producing formation Dry Hole  
If a producing well is abandoned, date of last production -- 19 --  
Was permission obtained from the Conservation Division or its agents before plugging was commenced? Yes

Name of Conservation Agent who supervised plugging of this well Mr. C. D. Stough  
Producing formation -- Depth to top -- Bottom -- Total Depth of Well 3900 Feet  
Show depth and thickness of all water, oil and gas formations.

OIL, GAS OR WATER RECORDS

CASING RECORD

Formation	Content	From	To	Size	Put In	Pulled Out
				8-5/8	247	None

Describe in detail the manner in which the well was plugged, indicating where the mud fluid was placed and the method or methods used in introducing it into the hole. If cement or other plugs were used, state the character of same and depth placed, from feet to feet for each plug set.

Heavy Rotary mud 3900' - 226 $\frac{1}{2}$ '  
Wood Plug 226 $\frac{1}{2}$ ' - 225'  
Cement 225' - 179' introduced by Halliburton  
Heavy Rotary Mud 179' - 31 $\frac{1}{2}$ ' introduced by Halliburton  
Wooden Plug 31 $\frac{1}{2}$ ' - 30'  
Cement 30' - 6' introduced by Halliburton  
Cellar - Surface 6' - 0'

RECEIVED  
Conservation  
AUG 25 1950  
STAFF


8-25-50

(If additional description is necessary, use BACK of this sheet)  
Correspondence regarding this well should be addressed to The Derby Oil Company  
Address Box 1030, Wichita, Kansas

STATE OF Kansas, COUNTY OF Sedgwick, ss.  
F. W. Heiser (employee of owner) or (owner or operator) of the above-described well,  
being first duly sworn on oath, says: That I have knowledge of the facts, statements, and matters herein contained and the log of the above-described well as filed and that the same are true and correct. So help me God.  
(Signature) F. W. Heiser  
Box 1030, Wichita, Kansas (Address)

SUBSCRIBED AND SWORN to before me this 23<sup>rd</sup> day of August, 1950

My commission expires August 24, 1953 Notary Public.

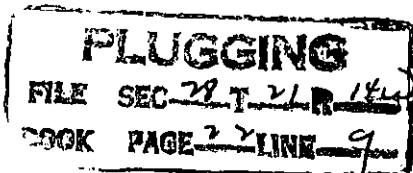

15.185.00619.0000

Contractor: Glenn Peel Drilling Company  
Drilling Commenced: 8-1-50  
Drilling Completed: 8-17-50  
Elevation: 1940 K.B.

THE DERBY OIL COMPANY  
#1 STRICKLER  
SE SE NE of Section 28-21-14W  
Stafford County, Kansas

Casing Record

248' of 8-5/8" 8 Rd New J-55 Surface Casing was set at 247'. Cemented with 150 sacks by Halliburton.

Driller's Log

<u>Formation</u>		<u>Bottom</u>
Surface Clay	0 -	14
Sand		240
Shale		367
Red Rock		384
Sand		767
Shale & Red Rock		836
Anhydrite		867
Shale		874
Shale & Shells		1110
Shale & Lime		1285
Shale & Shells		1347
Salt & Shale		1416
Shale & Shells		1617
Lime		2180
Shale & Lime		2965
Lime		3305
Lime & Shale		3430
Lime		3900
Total Depth		3900

Geological Data

<u>Formation</u>	<u>Top</u>	<u>Sub-Sea Datum</u>	<u>Remarks</u>
Heebner	3308	-1268	
Lansing	3437	-1497	No shows
Conglomerate	3694	-1754	
Viola	3740	-1800	
Simpson	3812	-1872	
Arbuckle	3840	-1900	
Total Depth	3900	-1960	Porosity 3870-71 and 3879-81

Completion Record

Dry and abandoned

**RECEIVED**

Conservation Div.

AUG 25 1950

STATE CORPORATION  
COMMISSION  
KANSAS

STATE OF KANSAS )  
                          ) ss  
COUNTY OF SEDGWICK )

I, the undersigned, being first duly sworn upon oath, state that this well record is true, correct, and complete, according to the records of this office and to the best of my knowledge and belief.

*E. W. Heiser*

E. W. Heiser, Exploitation Engineer  
The Derby Oil Company

Subscribed and sworn to before me this 23rd day of August, 1950.

**PLUGGING**  
WELL SEC. 28-21-14W  
BOOK PAGE 22 LINE 9

*H. A. Bilson*  
H. A. Bilson, Notary Public

My commission expires: August 24, 1953