

15-145-01169-0000

STATE OF KANSAS
STATE CORPORATION COMMISSION


Form CP-4

WELL PLUGGING RECORD

Give All Information Completely
Make Required Affidavit
Mail or Deliver Report to:
Conservation Division
State Corporation Commission
211 No. Broadway
Wichita, Kansas

Pawnee County, Sec. 4 Twp. 23 Rge. 17 (E) W (W)

NORTH

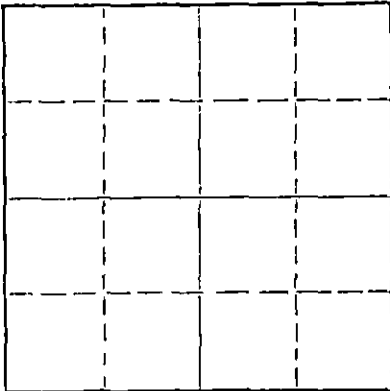

Locate well correctly on above
Section Plat

Location as "NE/CNW/SW" or footage from lines NE SE SW

Lease Owner The Bovaird Supply Company

Lease Name Welch Well No. 3

Office Address Great Bend, Kansas

Character of Well (completed as Oil, Gas or Dry Hole) _____

Date well completed _____ 19__

Application for plugging filed _____ 19__

Application for plugging approved _____ 19__

Plugging commenced 3-1-65 _____ 19__

Plugging completed 4-12-65 _____ 19__

Reason for abandonment of well or producing formation Depleted.

If a producing well is abandoned, date of last production _____ 19__

Was permission obtained from the Conservation Division or its agents before plugging was commenced? yes

Name of Conservation Agent who supervised plugging of this well Eldon Petty

Producing formation _____ Depth to top _____ Bottom _____ Total Depth of Well 4300 Feet

Show depth and thickness of all water, oil and gas formations.

OIL, GAS OR WATER RECORDS

CASING RECORD

FORMATION	CONTENT	FROM	TO	SIZE	PUT IN	PULLED OUT
				8-5/8"	277'	None
				5-1/2"	4299'	2605'

Describe in detail the manner in which the well was plugged, indicating where the mud fluid was placed and the method or methods used in introducing it into the hole. If cement or other plugs were used, state the character of same and depth placed, from _____ feet to _____ feet for each plug set.

Checked hole to 4250', pushed plug to 4080', set rockbridge to 4060' and dumped 4 sacks of cement @ 4060' with dump bailer. Pulled 5 1/2" casing and pumped in 40 sacks of gel mud and 95 sacks of cement. Capped well with 5 sacks of cement.

RECEIVED
STATE CORPORATION COMMISSION

PLUGGING COMPLETE.

APR 23 1965

4-23-65

CONSERVATION DIVISION
Wichita, Kansas

(If additional description is necessary, use BACK of this sheet)

Name of Plugging Contractor KNIGHT CASING PULLING COMPANY

Address CHASE, KANSAS

STATE OF KANSAS, COUNTY OF RICE, ss.

Noel J. Knight (employee of owner) or (~~owner or operator~~) of the above-described well, being first duly sworn on oath, says: That I have knowledge of the facts, statements, and matters herein contained and the log of the above-described well as filed and that the same are true and correct. So help me God.

(Signature) Noel J. Knight

Chase, Kansas
(Address)

SUBSCRIBED AND SWORN TO before me this 15th day of April, 1965

My commission expires May 20, 1968

Milton J. Volin
Notary Public.

15-145-01169-0000

ROONEY, SIEGFRIED & THOMAS

D. B. Welch, Well #3
NE SE SW Sec. 4-23S-17W
Pawnee County, Kansas

Casing Record:
8 5/8" @ 277' w/ 225 sx.
5 1/2" @ 4299' w/ 150 sx.

Commenced: October 6, 1955
Completed: October 21, 1955

Elevation: 2085 D. F.

LOG

Surface clay, sand & shale	0-200
Shale	200-277
Shale & Shells	277-540
Sand Dakota	540-660
Shale, shells & red beds	660-855
Red beds, shale & shells	855-1120
Anhydrite	1120-1155
Shale & shells	1155-1475
Shale & salt	1475-1575
Shale & lime	1575-1745
Shale, shells & lime	1745-1985
Lime	1985-2485
Sandy lime	2485-2560
Shale & lime	2560-2640
Lime & shale	2640-2855
Shale & lime	2855-3085
Lime & shale	3085-3165
Lime	3165-3680
Lime & shale	3680-3744
Lime	3744-4165
Cherty conglomerate	4165-4220
Chert	4220-4248
Cherty conglomerate	4248-4300 RTD

I hereby certify that this log is true and correct to the best of my knowledge and belief.

JAYHAWK DRILLING CO., INC.

By John Little

Sworn and subscribed to before me
this 24th day of October, 1955.

Allen P. Denton
Notary Public

My Commission Expires: August 13, 1957

RECEIVED
STATE CORPORATION COMMISSION
APR 6 1965
CONSERVATION DIVISION
Wichita, Kansas