

STATE OF KANSAS
STATE CORPORATION COMMISSION


Form CP-4

WELL PLUGGING RECORD

Give All Information Completely
Make Required Affidavit
Mail or Deliver Report to:
Conservation Division
State Corporation Commission
211 No. Broadway
Wichita, Kansas

Pawnee County. Sec. 4 Twp. 23S Rge. 17W(E) (W)
Location as "NE/CNW/SW" or footage from lines Ne/NE/Sw

NORTH

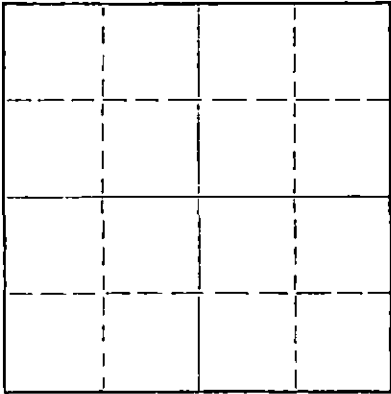

Locate well correctly on above
Section Plat

Lease Owner Bovaird Supply
Lease Name A.W. Schartz. Well No. #2
Office Address Box 789, Great Bend Kansas.
Character of Well (completed as Oil, Gas or Dry Hole) Oil.
Date well completed 9/29 1955
Application for plugging filed 3/2 1965
Application for plugging approved 4/7 1965
Plugging commenced 4/8 1965
Plugging completed 5/4 1965
Reason for abandonment of well or producing formation Dry.

If a producing well is abandoned, date of last production 1/1 1965
Was permission obtained from the Conservation Division or its agents before plugging was commenced? Yes.

Name of Conservation Agent who supervised plugging of this well Eldon Petty.
Producing formation Mississippian Chat. Depth to top 4236 Bottom 4238 Total Depth of Well 4243 Feet
Show depth and thickness of all water, oil and gas formations.

OIL, GAS OR WATER RECORDS

CASING RECORD

FORMATION	CONTENT	FROM	TO	SIZE	PUT IN	PULLED OUT
				5-1/2	4247	3129

Describe in detail the manner in which the well was plugged, indicating where the mud fluid was placed and the method or methods used in introducing it into the hole. If cement or other plugs were used, state the character of same and depth placed, from _____ feet to _____ feet for each plug set.

Sanded Back 5-1/2 Oil string from 4248 to 4140 mixed and dumped 4sx cement on sand bridge.
Squeezed Well through 8-5/8 csg with sun cementing company pumped 40sx gell And 100 sx Cement Through 8-5/8 Csg to top of csg.

RECEIVED
STATE CORPORATION COMMISSION

JUN 9 1965

CONSERVATION DIVISION
Wichita, Kansas

(If additional description is necessary, use BACK of this sheet)

Name of Plugging Contractor Apex casing pulling company.
Address 739 East 2Nd. Hoisington Kansas.

STATE OF Kansas. COUNTY OF Barton. ss.

(employee of owner) or (owner or operator) of the above-described well, being first duly sworn on oath, says: That I have knowledge of the facts, statements, and matters herein contained and the log of the above-described well as filed and that the same are true and correct. So help me God.

(Signature) Benn Thompson
739 East 2nd Hoisington Kan
(Address)

SUBSCRIBED AND SWORN TO before me this 8th day of June, 1965

My commission expires Dec. 8, 1968

Notary Public.

R. W. PAT CLOWERS GEOLOGIST

2324 BROADWAY GREAT BEND, KANSAS PHONE 7471

ROONEY, SIEGFRIED & THOMAS

A. W. SCHARTZ NO. 2
 NE NE SW, Sec. 4-23S-17W
 Pawnee County, Kansas

Contractor: Jayhawk Drilling Company
 Tool Pusher: Bill Little
 Spudded: April 14, 1955
 Surface Csg: 8 5/8" set @ 315 ft. with 250 sacks cement plus 2% CaCl₂.
 Oil String: 5 1/2" casing set @ 4247 ft. with 150 sacks Posmix.
 Shoe Joint: 16.25'
 Zero: Reference 4.40 above original ground level.

15-145-61164-0000

GEOLOGICAL REPORT

Samples each 5 ft. and 1 ft. drilling time were taken from 3500 ft. to R. T. D. (4248 ft.)

The following data compiled through sample examination and Welex log correlation.

ALL MEASUREMENTS ARE TAKEN FROM ROTARY BUSHING.

Elevation: 2069 K.B. 2067 D.F. 2064 Ground

<u>FORMATION</u>	<u>DEPTH</u>	<u>SUB-SEA</u>	<u>THICK</u>	<u>SOURCE</u>
Anhydrite	1095 - 1118	∕ 974 to ∕ 951	23'	Welex
Heebner Shale	3606	-1537	5'	"
Douglas	3635	-1566		
Brown Lime	3713	-1644		
Lansing-Kansas City	3721	-1652		
Shaley Conglomerate	4128	-2059		
Cherty Conglomerate	4158	-2089		
Rotary Total Depth	4248	-2179		

SAMPLE DESCRIPTION

Note: All sample descriptions and drilling measurements must be corrected up hole 3 ft.

4100 - 15: Dark greenish shale with crystalline lime.
 15 - 20: Same; show white chalky lime.
 20 - 25: Same; predominantly brown and green shale.
 25 - 30: Same abundant weathered lime.

RECEIVED
 STATE CORPORATION COMMISSION

JUN 9 1955

CONSERVATION DIVISION
 Wichita, Kansas